


Section 29 Township 21 Range 14 W

Well No. # 2 Weirauch

Company Westgate-Greenland

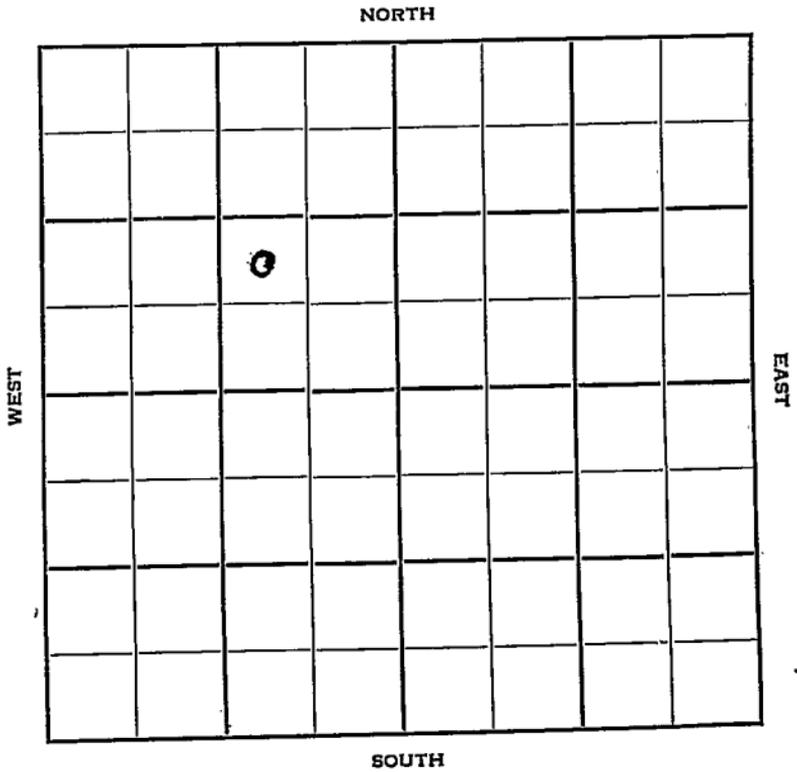

Stafford KANSAS

29

21

14W

Sec. _____ Twp. _____ R. _____

#2 Weirauch

Well No. _____ Farm _____

Westgate- Greenland

Company _____

W-G

Contractor _____

_____ Ft. from N. Line

990


_____ Ft. from S. Line

990

_____ Ft. from E. Line

_____ Ft. from W. Line

NW SE NW

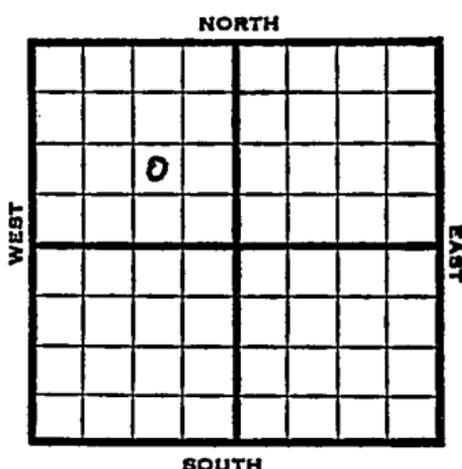

1953

Elev. 1947' REPORT

4/15

Spud 4-10-53

8" @ 228

Drlg. 1814'

4/23

Drlg. 3363'

4/30

Heeb 3289' Br li 3402' Lans 3414

DST 3544-82, 1 hr, 110' W & M
1080#

B KC 3638 Cong 3664 V 3677

Simp 3723 Arb. 3777

DST 3779-91 RTD 1 hr, 420' VSMCO

3' Wtr. 1050# 5" @ 3790

5/7

59/3278-90, FU 200' fluid 3 hrs.

S/1 boph + 10% W, 500A

S/10 boph + 20% W 6 hrs.

5/20

Spud 4-10-53

Oil Well

TD 3791'

8" @ 228'

Heeb 3289, Br. Lime 3402, Lans 3414,

DST 3544-82 opn 1 hr, rec 110' wtr &

mud 1080# B KC 3638, Cong 3664,

Viola 3677, Simp 3723, Arb 3777.

DST 3779-91 opn 1 hr, rec 420' vsmco

3' wtr. 1050#

5" @ 3790'

OVER

