


DX 78-1 Rice

KANSAS

Section 29 Township 21S Range 7W

Well No. #1 Wilt

Company Francis M. Raymond

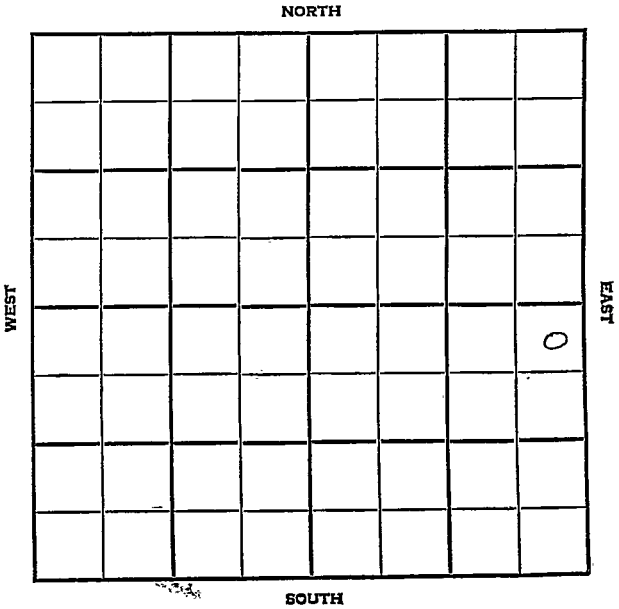

SEC. 29	TWP. 21	R. 7W
------------	------------	----------

WELL NO. #1 Wilt FARM

COMPANY Francis M. Raymond

CONTRACTOR


WILDCAT

_____ FT. FROM N. LINE

_____ FT. FROM S. LINE

_____ FT. FROM E. LINE

_____ FT. FROM W. LINE

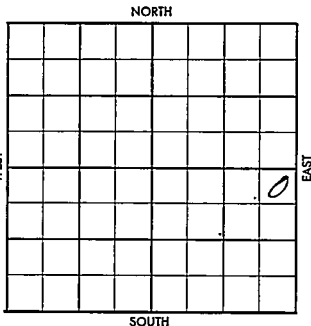

NE NE SE

1956	ELEVATION 1610'	REPORT
------	--------------------	--------

8-8 Loc.

8-22 Comm. 8-10-56
 8 5/8" @ 214 w/175
 DST 3440-48 op 140 min. rec. 210' gssy
 mdy wtr., / 60' MSW / scum / 120' SW,
 BHP 885/20".
 D & A
 H. 2751'; Dg. 2770'; BL. 2922';
 L. 2946'; BKC 3310'; G.Sd. 3413';
 Base cg. 3418'; M.Chert 3440';
 TD 3448'

ABANDONED

County Rice Elev. _____
 Sec. 29 Twp. 21S Rgs. 7W
 Company Francis M. Raymond
 Farm Name Wilt No. 1

TOPS	DEPTH	LOG	DATUM
Anh.			
TP.			
H.			
Tr.			
Dg.			
Bl.			
L.			
K.C.			
B.K.C.			
Ce.			
C.			
M.			
M.			
K.			
Mz.			
Ma.			
V.			
S.			
S.			
A.			
R.			
PE.			
G.			
T.B.			

Loc. in Sec. NE NE SE

Geol. _____
 Contr. _____

Pool W. C.

AUG 8 '56

Date Comm. _____
 Loc. _____

(Large handwritten scribble across the bottom section)

Co.

Loc.

No.

Sec.

T.

R.

County Rice Elev. 1610
 Sec. 29 Twp. 21S Rge. 7W
 Company Francis M. Raymond
 Farm Name Wild No. 1

TOPS	DEPTH	LOG	DATUM
Anb. <u>11</u>			
Tr.			
H.	<u>2751</u>		
Tr.			
Dg.	<u>2770</u>		
Bl.	<u>2922</u>		
L.	<u>2946</u>		
K.C.			
B.K.C.	<u>3310</u>		
Ce.			
C. <u>sd</u>	<u>3413</u>		
M. <u>Base c9</u>	<u>3418</u>		
M. <u>chart</u>	<u>3440</u>		
K.			
Mz.			
Mo.			
V.			
S.			
S.			
A.			
R.			
PE.			
G.			
TD.	<u>3448</u>		

Loc. in Sec. NE NE SE

Geol. _____

Contr. _____

Pool _____

W. C. _____

ABANDONED

Date Comm. _____

AUG 22 1956

Loc. Aug 15 '56 8-10-56 8⁵/8 214

1175-D 2830 AUG 22 '56

DST. 3440-48 140" net 210'

955y Mdy wt (550) + 60' MSW

+ SCUM + 120' SW BHP 885/20"

D&A