

Map No. KANSAS Sec. 29 Twp. 21 R. 9^w

Well No. 1-Wellman Farm

United But Company


330 Ft. from N. Line

_____ Ft. from S. Line

330 Ft. from E. Line

_____ Ft. from W. Line

1930

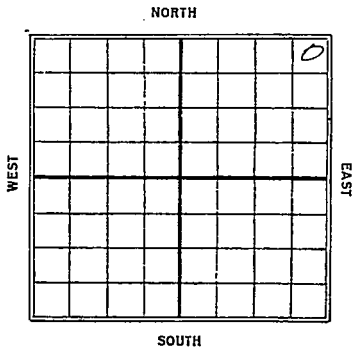

Date

REPORT

Date	REPORT
7/9	Pond
7/16	—
7/23	—
7/30	Roll.
8/6	—
8/13	110' of 20"
8/20	dry 710'
8/27	1475'
9/3	VIR. 10" - 2005'
9/10	dry 2075'
9/17	Sledge 10" - 2090'
9/24	40" - 2090'
	dry 2210'
10/1	S.D. 2455'
10/8	HFW 2518'
	dry 2525'
10/15	Test tools 2720'
10/22	dry 2895'
10/29	VIR 6" - 3095'
11/5	6" - 3102' dry. 3157'
11/12	6" - 3118' T.D. 3185'
	S.D.

11/19- 6"- 3180
Dully 3305

11/25- Viola 3415', show
oil 3435' 5"- 3435

10ulg. 3445'

12/2- HFW 3485-92

S.D. 3550' T.D.

12/10- Dully 3553

12/17- T.D. 3555

dry & abandoned

Rice
Map No. **KANSAS** Sec. *29* Twp. *21* R. *9W*

49
Well No. *1 Wellman*

United P. & O. Company

Contractor

SECTION PLAT

300 Ft. from N. Line

..... Ft. from S. Line

300 Ft. from E. Line

..... Ft. from W. Line

			0

FIRST REPORTS

Location.....

Rig up.....

Drilling and Remarks:

Sand

RECORD

Cased..... in., ft.

Sand.....

Gas.....

Oil.....

Total Depth.....

PRODUCTION

1st 24 hrs. Nat.....

1st 24 hrs. after shot.....

Gas..... Cu. Ft.

Dry Hole.....

Abandoned.....

Date

JUL 9 1930

S. J. LEWIS

Scout

Rice
 Map No. **KANSAS** Sec. *29* Twp. *21* R. *9W*
 Well No. *1 McEllman*

United P & O Company

Contractor

SECTION PLAT

			0

330 Ft. from N. Line

..... Ft. from S. Line

330 Ft. from E. Line

..... Ft. from W. Line

ABANDONED

Location.....

Rig up.....

Drilling and Remarks:

RECORD

Cased.....in.,ft.

Sand.....

Gas.....

Oil.....

Total Depth *3555*

PRODUCTION

1st 24 hrs. Nat.....

1st 24 hrs. after shot.....

Gas.....Cu. Ft.

Dry Hole.....

Abandoned.....

Date

DEC 17 1930

S. J. LEWIS

Scout