

Rice


FORM 51

KANSAS

Section 29 Township 21 Range 10W

Well No. 1 - Proffitt

Company Braden Drlg

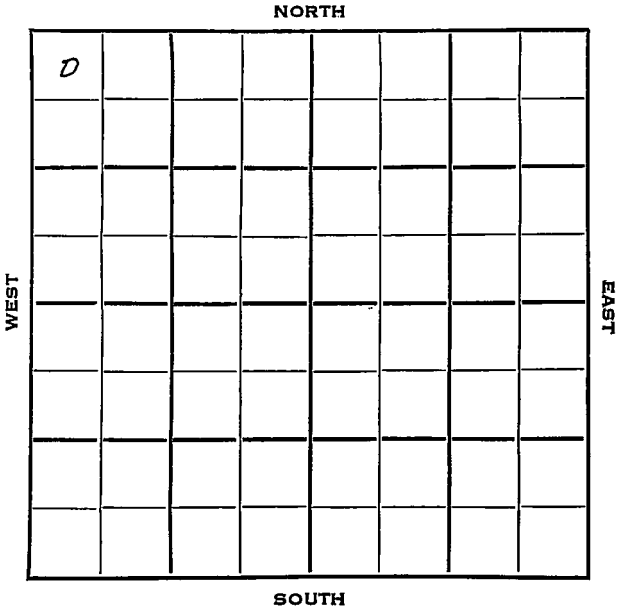


Rice

KANSAS
10W ✓Sec. 29 Twp. 21 R. 10WWell No. 1 Proffitt FarmBraden Drlg. CompanyBraden Drlg. Contractor

Wildcat

330 Ft. from N. Line Ft. from S. Line Ft. from E. Line330 Ft. from W. Line

NW NW NW

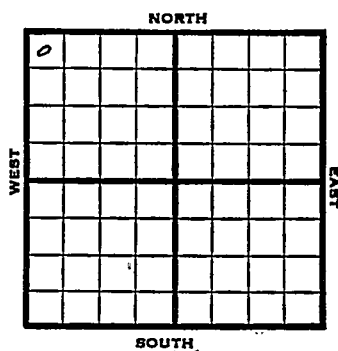

1952 Elev. 1736' REPORT Elev. 1736

12/30 Location (CSO farmout)

1/1 Location

1/8 8" @ 178 Br 1 3049 Lans 3070) Ø3103

1953

1/14

Spud 12-29-52

D&A TD 3492

8" @ 178

Heeb 2913, Br lime 3049, Lans

3070, B KC 3342, Cong 3361,

Viola 3373

DST 3374-86, opn 3/4 hrs.,

rec. 30' mud, 0#

Simp 3403

DST 3422-46, opn 1 hr., rec.

1000' sw 1150#

Arb. 3465

TD 3492

D&A

ABANDONED

County Rice State KansasSec. 29 (Blk. Twp.) 21 (Sur. Rge.) 10W Map No.Operator Braden Drlg.Well No. 1 Farm ProffittElev. 1736 Location NW NW NW

0						

330 Ft. From N Line NW330 Ft. From W Line Quarter1st. Report DEC 30 1952

Completion

Remarks CSO farmoutBraden Drlg. - Contr.

Spudding Date

Drlg. Data WildcatLocation

County Rice State KansasSec. 29 (Blk.
Twp.) 21 (Sur.
Rge.) 10W Map No.Operator Braden Drlg.Well No. 1 Farm ProffittElev. 1736 Location NW NW NW

0							

330 Ft. From N Line NW330 Ft. From W Line Quarter

1st. Report

Completion JAN 14 1953Remarks WildcatBraden Drlg. - Contr.Spudding Date 12-29-52Drlg. Data D & A TD 34928" @ 178 Heeb. 2913 Br. lime 3049Lans. 3070 B KC 3342. Cong. 3361Viola 3373 DST 3374-86 open 3/4 hr.Rec. 30' mud 0# Simp. 3403DST 3422-46 open 1 hr. Rec. 1000' sw1150# Arb. 3465 TD 3492D & A