

Pawnee


KANSAS

SECTION 29 TOWNSHIP 21 RANGE 19 W

WELL NO. #1 Riederer

COMPANY Welch & Olsson

NORTH

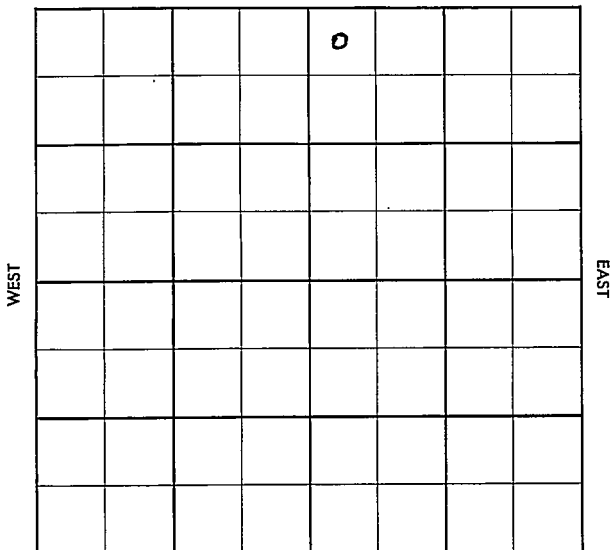

Pawnee

KANSAS

SEC.	TWP.	R.
29	21	19W

WELL NO.

#1 Riederer

FARM

COMPANY

~~####~~ Welch & Olsson

CONTRACTOR

WILDCAT


_____ Ft. from N. Line

_____ Ft. from S. Line

_____ Ft. from E. Line

_____ Ft. from W. Line

NW NW NE

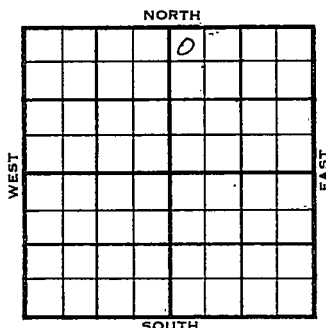

	ELEVATION	REPORT
1955	2082'	
12-21	Location	
1956		
1-18	Comm. 12-23-55 8 5/8" @ 205/175 DST 4188-4230 op 1 hr. rec. 1500' sw, 30# D & A H. 3621 L. 3685 C. 4194 M. 4262 Mz. 4319 V. 4351 TD 4390'	
ABANDONED		

County Paynee Elev. _____
 Sec. 29 Twp. 21 Rge. 19W
 Company Welch & Olsson
 Farm Name Riederer No. 1

TOPS	DEPTH	LOG	DATUM	Loc. in Sec.
Anh.				NW NW NE
TP.				
H.				
Tr.				
Dg.				
Bl.				
L.				Geol.
K.C.				
B.K.C.				Contr.
Ce.				
C.				
M.				
M.				Pool
K.				Wildcat
Mz.				
Me.				
V.				
S.				
S.				
A.				
R.				
PE.				
G.				
FD.				

Lse

No.

DEC 21 1955
 FIRST REPORT

Date Comm. _____

Location

5

Use:

No.

Sec.



County Pawnee Elev. 2082Sec. 29 Twp. 21 Rge. 19WCompany Welch & OlssonFarm Name Riederer No. 1

TOPS DEPTH LOG DATUM

Anb. _____

Tp. _____

H. 3621

Tr. _____

Dg. _____

BL. _____

L. 3685

K.C. _____

B.K.C. _____

Ce. _____

C. 4194M. 4262

M. _____

K. _____

Mz. 4319

Mq. _____

V. 4351

S. _____

S. _____

A. _____

R. _____

PE. _____

G. _____

T.D. 4390

Loc. in Sec. _____

NW NW NE

Geol. _____

Contr. _____

Pool _____

Wildcat

ABANDONED

Date Comm. 12-23-55 JAN 1 8 19568 5/8" @ 205/175 DST 4188-4230open 1 hr. rec. 1500' SW 30#

D & A