

KANSAS


Form 51-5M-7-40-Palace

Stafford

Section 3 Township 21 Range 13-W

Well No. #1 Shaeffer

Company Landon & Faulkner

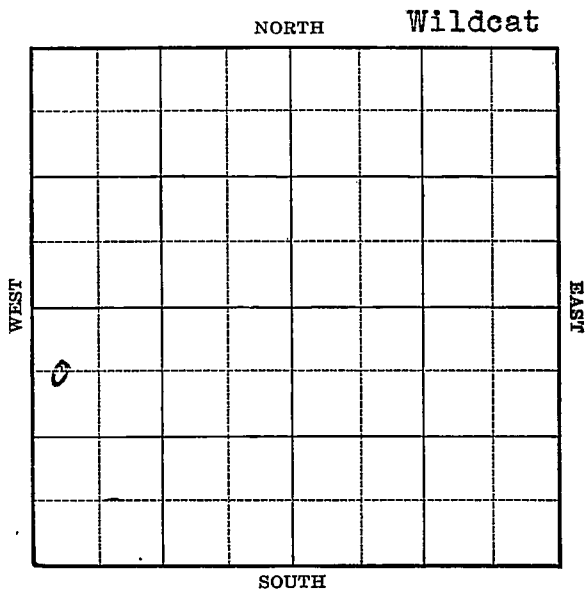

1941	REPORT
1/22	Location
1/30	Derrick.
2/6	10" - 273' Anhy 743'
	Drlg. 1700'
2/13	Topeka 2880' Drlg. 2922'
2/20	Lans. 3279' S.O. 3404-07 & 3426-30' Cong. 3504'
	Simpson 3510' Arb. 3536-42' TD
	S.O. 5" - 3536' RUST.
2/27	Shut down.
3/6	T.D. 3546' Shot 5 qts. 4500 acid. 50' oil 7½ hrs.
3/13	T. D. 3552' 2000 acid. Swab 200 bbls. in 5 hours, 1000' off bottom. 30.7 Gravity
	OVER

1941
3/19

Arb. 3536'

5" - 3536'

T.D. 3552'

Shot 5 qts.

4500 acid.

Depthograph potential 1175 bbls.

30.7 Gravity


COMPLETED

Map No. 82 Sec. 3 Twp. 21 R. 13WWell No. 1 ShaëfferLandon & Faulkner CompanyContractor**FIRST REPORT**

C W L NW SW

660 Ft. from N. Line Ft. from S. Line Ft. from E. Line330 Ft. from W. Line

WILDCAT

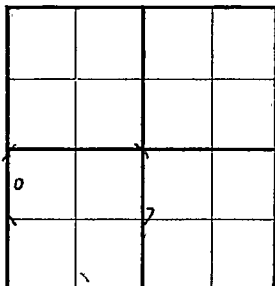SECTION PLATLocation XRig up

Drilling and Remarks:

RECORDCased in., ft.Sand Gas Oil Total Depth **PRODUCTION**1st 24 hrs. Nat. 1st 24 hrs. after shot Gas Cu. Ft.Dry Hole Abandoned

Date

JAN 22 1941 19S. J. LEWIS Scout

Misc Small Maps	_____
Cards	_____
Tracing	_____
France Map	_____
Scarborough Map	_____
Moody Map	_____
Geological Dept.	_____
Moody Map Book	_____

Map No. 82 Sec. 3 Twp. 21 R. 13WWell No. 1 ShaefferLandon & Faulkner

Company

Contractor

COMPLETED

SECTION PLAT

C W L N W S W

660 Ft. from N. Line Ft. from S. Line Ft. from E. Line330 Ft. from W. Line

0			

WILDCAT

Location Rig up

Drilling and Remarks:


RECORD

Cased in., ft.Sand Gas Oil Total Depth 3552

PRODUCTION

1st 24 hrs. Nat. 1st 24 hrs. after shot Gas Cu. Ft.Dry Hole Abandoned

Date

MAR 19 1941 19

S. J. LEWIS Scout

Misc Small Maps
Cards
Tracing
France Map
Scarborough Map
Moody Map
Geological Dept.
Moody Plat Book