

KANSAS

Section 3 Township 21 Range 11W

Well No. #1 Davis

Company Adkin Drlg.

NORTH

						0	

WEST

EAST

SOUTH

Stafford

KANSAS

Sec. 3 Twp. 21 R. 14 W

Well No. # 1 Davis Farm

Adkin Drlg. Company

Contractor

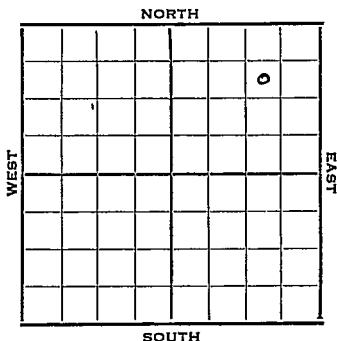
Wildcat

990 Ft. from N. Line

Ft. from S. Line

990 Ft. from E. Line

Ft. from W. Line



SW NE NE

1951

Elev. 1923'

REPORT

11/28

Spud 11-24-51

8" @ 207'

Drlg. 966'

12/19

Spud 11-24-51

Oil well TD 3635' 8" @ 207

Heeb 3200'

Br. lime 3312'

Lans. 3326'

DST 3330-63 open 1 hr. rec 35' mud

DST 3450-59 open 1 hr. rec 90' OCM

B KC 3546'

Arb. 3628-35

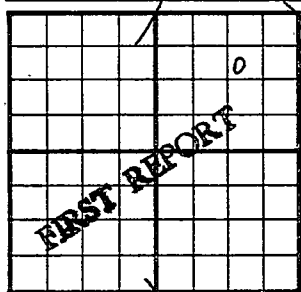
5" @ 3629' CO to 3594 12/3483-87

S/1 BOPH 1500 A S/33 BOPH

S/15 BOPH

Comp. 397 BOPD

COMPLETED

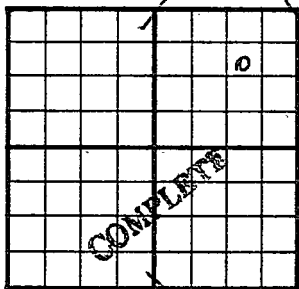
County Stafford State KANSASSec. 3 (Blk. Twp.) 21 (Sur. Rge.) 14W Map No.Operator Adkin Drlg.Well No. 1 Farm DavisElev. Location SW NE NE990 Ft. From N Line NE990 Ft. From E Line Quarter1st. Report NOV 28 1951

Completion

Remarks

Spudding Date 11-24-51Drlg. Data Wildcat8" @ 207 drlg. 966

U: E TYRA

County Stafford State KansasSec. 3 (Blk. Twp.) 21 (Sur. Rge.) 14W Map No.Operator Adkin Drlg.Well No. 1 Farm DavisElev. 1923 Location SW NE NE990 Ft. From N Line NE990 Ft. From E Line Quarter

1st. Report

Completion DEC 1 9 1951Remarks WildcatSpudding Date 11-24-51Drlg. Data Oil well TD 36358" @ 207 Heeb. 3200 Br. lime 3312Lans. 3326 DST 3330-63 open 1 hr.Rec. 35' mad DST 3450-59 open 1 hr.Rec. 90' ocm B KC 3546 Arb. 3628-355" @ 3629 CO to 3594 12/ 3483-87S/ 1 boph 1500 A S/ 33 bophS/ 15 boph Comp. 397 bopd

J. E. TYRA