
FORM 51 25M 3-49 PETROL Rice KANSAS

Section 3 Township 21 Range 7W

Well No. #1 Pollister

Company Tom Allen & CRA

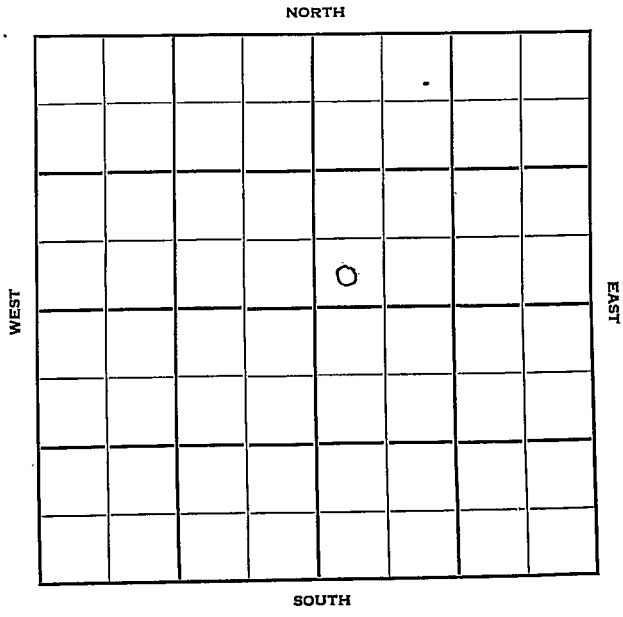

FORM 252-B
10M 8-51 TPCO.

Rice KANSAS ✓

Sec. 3 Twp. 21 R. 7 W

Well No. # 1 Pollister Farm

Tom Allen & CRA Company

Tom Allen Contractor


Ft. from N. Line

330 Ft. from S. Line

Ft. from E. Line

330 Ft. from W. Line

SW SW NE

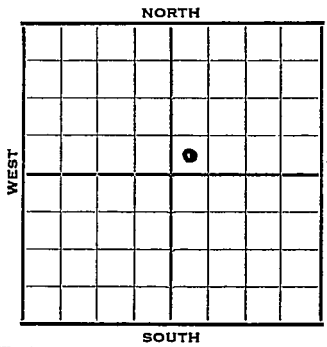

1952	Elev. 1618' REPORT
9/17	Spud 9-6-52 8" @ 152 Drlg. 3048'
9/24	Cong 3342 Sdy Cong 3349 RTD 3350 5" @3344 DD @ 3364
10/1	Miss. 3351 TD 3420 20 galoph hole caving PB 3359 45' of 4½" liner
10/8	Spud 9-6-52 Oil well TD 3420' 8" @ 152 Cong. 3342' Sdy Cong. 3349' TD 3350' 5" @ 3344' DD 3364' Miss 3351' TD 3420' 20 GOPH Hole caving. PB 3359' 45' of 4½" liner
1	CO to 3380' Hydro. Comp. 25 BOPD 10 BW

COMPLETED

FORM 275 FOR SALE BY KANSAS BLUE PRINT CO.


County Rice State Kansas

Sec. 3 (Blk. Twp.) 21 (Sur. Rge.) 7W Map No.

Operator Tom Allen & CRA

Well No. 1 Farm Pollister

Elev. Location SW SW NE

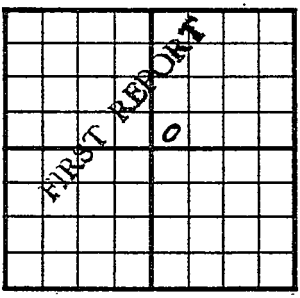

330 Ft. From S Line NE

330 Ft. From W Line Quarter

1st. Report SEP 17 1952

Completion

Remarks

Tom Allen - Contr.

Spudding Date 9-6-52

Drlg. Data

8" @ 152 Drlg. 3048

J. G. McGEHEE

FORM 275 FOR SALE BY KANSAS BLUE PRINT CO.


County Rice State Kansas

Sec. 3 (Blk. Twp.) 21 (Sur. Rge.) 7W Map No.

Operator Tom Allen & CRA

Well No. 1 Farm Pollister

Elev. 1618 Location SW SW NE

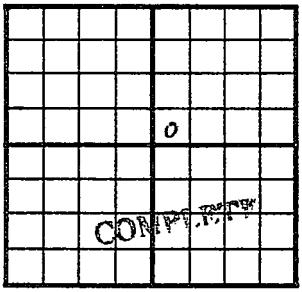

330 Ft. From S Line NE

330 Ft. From W Line Quarter

1st. Report

Completion OCT 8 1952

Remarks

Tom Allen - Contr.

Spudding Date 9-6-52

Drlg. Data Oil well TD 3420

8" @ 152 Cong. 3342 Sdy Cong. 3349

TD 3350 5" @ 3344 DD 3364 Miss. 3351

TD 3420 20 goph hole caving PB 3359

45' of 4½" liner CO to 3380 Hydro.

Comp. 25 bopd 10 bw

J. G. McGEHEE