FORM 51 25M 3-49 PETROL


Rice

KANSAS

Section 3 Township 21 Range 7 W

Well No. # 1 McDill

Company Tom Allan

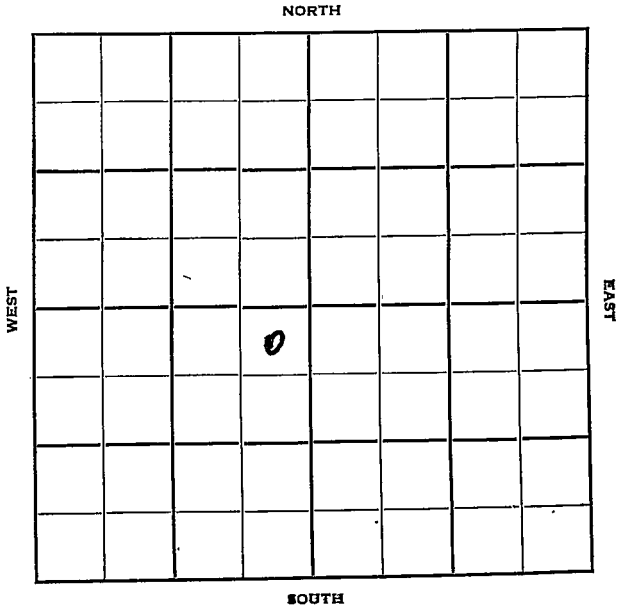

FORM 252-B
10M 11-50 PETROL

Rice

KANSAS

Sec. 3 Twp. 21 R. 7W

Well No. #1 McDill Farm

Tom Allan Company

" Contractor

Wherry Pool


330 Ft. from N. Line

Ft. from S. Line

330 Ft. from E. Line

Ft. from W. Line

NE NE SW

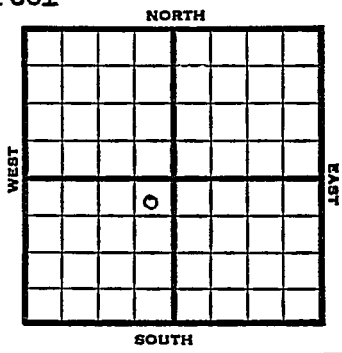

1952	Elev. 1614' REPORT
10/8	Spud 10-4-52 8" @ 150' Drlg. 1160'
10/15	Drlg. 3105'
10/22	Lans. 2881' Cong. 3338' 5" @ 3337 Drlg. 3356½'
10/29	DD 3358 TD FU 1400' oil S/4 BO & 8 BWPH 16 hrs.
11/5	60 BOPD + 10% wtr.
11/12	Spud 10-4-52 Oil Well TD 3358' 8" @ 150 Lans 2881', Cong 3338', 5" @ 3337 TD 3358 FU 1400' oil S/4 boph 8 bw 16 hrs.- Comp. 35 bopd 10% wtr.

COMPLETED

FORM 275 FOR SALE BY KANSAS BLUE PRINT CO.


County Rice State Kansas

Sec. 3 (Blk. Twp.) 21 (Sur. Rge.) 7W Map No.

Operator Tom Allan

Well No. 1 Farm McDill

Elev. Location NE NE SW

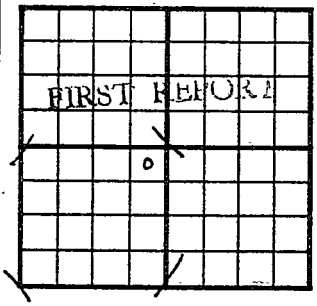

330 Ft. From N Line SW

330 Ft. From E Line Quarter

1st. Report OCT 8 1952

Completion

Remarks Tom Allan - Contr.

Spudding Date 10-4-52

Drlg. Data Cherry Pool

8" @ 150 drlg. 1160

J. G. McGEHEE

FORM 275 FOR SALE BY KANSAS BLUE PRINT CO


County Rice State Kansas

Sec. 3 (Blk. Twp.) 21 (Sur. Rge.) 7W Map No.

Operator Tom Allan

Well No. 1 Farm McDill

Elev. 1614 Location NE NE SW

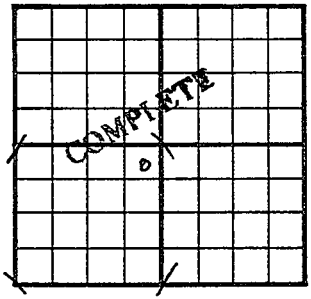

330 Ft. From N Line SW

330 Ft. From E Line Quarter

1st. Report

Completion NOV 12 1952

Remarks Wherry Pool

Tom Allan - Contr.

Spudding Date 10-4-52

Drlg. Data Oil well TD 3358

8" @ 150 Lans. 2881 Cong. 3338

5" @ 3337 TD 3358 FU 1400' oil

S/ 4 boph 8 bw 16 hr.

Comp. 55 bopd 10% wtr.

J. G. McGEHEE