


Section 3 Township 21 Range 7W

Well No. #1 McDill

Company T.H. Allen

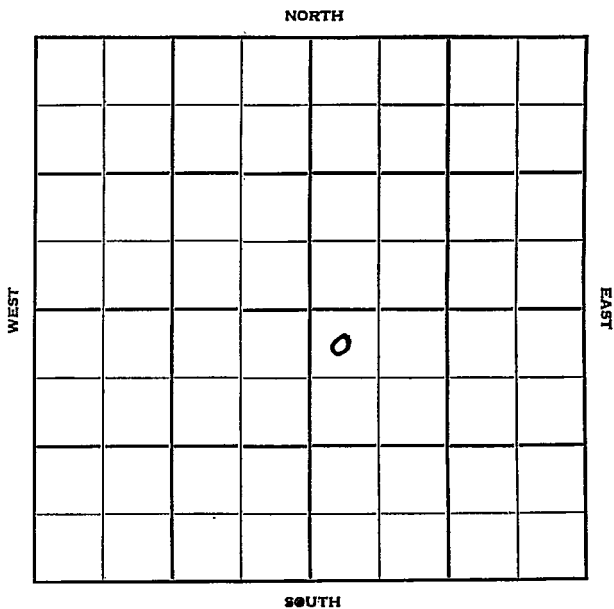

Sec. 3 Twp. 21 R. 7 W

Well No. # 1 McDill Farm

T. H. Allen Company

Contractor


330 Ft. from N. Line

Ft. from S. Line

Ft. from E. Line

330 Ft. from W. Line

NW NW SE

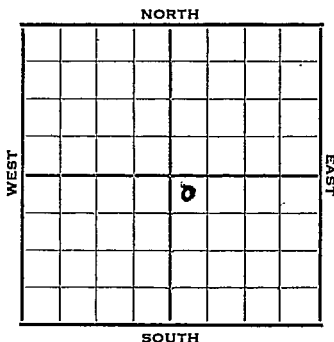

1952

Elev. 1614' REPORT

7/9 Spud 7-3-52

7/17 8" @ 140
Drlg. 3250'

7/23 Cong. 3341 RTD 3345
5" @ 3345 DD 3361 fill up 900' oil
2 hrs. S/ 3 Boph for 16 hrs. POP

7/30 NR

8/6 "

8/13 "

8/20 Pay Zn 3353-60½ P/30 bopd

8/27 Spud 7-3-52
Oil Well TD 3361' 8" @ 140'
Cong. 3341 TD 3345 5" @ 3345
DD 3361 FU 900' oil 2 hr.
S/ 3 boph Comp. 25 bopd

COMPLETED

