


QAWD
DX-78-1

RICE

KANSAS

Section 3 Township 21S Range 8W
Well No. #1 Humphreys
Company Sterling Drlg. Co.

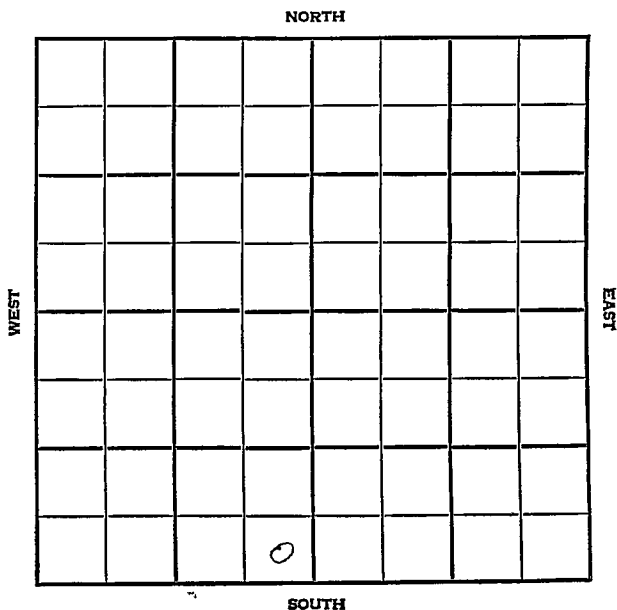

0111111

Rice

KANSAS

SEC.

3

TWP.

21

R.

8W

WELL NO.

#1 Humphreys

FARM

COMPANY

Sterling Drlg. Co.

CONTRACTOR

Wherry


____ FT. FROM N. LINE

____ FT. FROM S. LINE

____ FT. FROM E. LINE

____ FT. FROM W. LINE

SE SE SW (OWWO? on Twin 2)

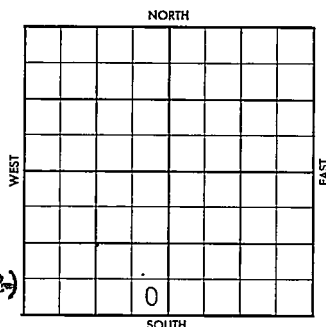SDX - $\frac{1}{2}$ mile

1956

ELEVATION

1649 KB

REPORT

6-13

Location

Spud 6-19-56

6-21

Heeb 2746, Br Ls 2885, Lsg 2916,
 Congl 3272, Miss 3297, Viola 3587,
 Simp 3610, Arb 3678,
 TD 3695
 to CO and test gas in Congl and Miss

6-28

NR

7-6

NR

7-12

WOCT

7-19

No report

7-26

No report

8-2

CO to 3350

5 $\frac{1}{2}$ " @ 3350

8-9

CO 32/3220-80, 32/3280-88, gas in 43
 min,
 CO to 3350, 500 A, 530 MCFGPD,
 to frac

8-15

SIP 980#; ga 530 MCFGPD

Op flow 3,210 MCFG, RP 710#

H. 2746'; BL. 2885'; L. 2916'; C. 3272';
 M. 3297'; V. 3587'; S. 3610'; A. 3678';

TD 3695'

COMPLETED

Used the W.O. I dont believe it
is a twin (Harold Pittenger)

FORM 513 SUNRAY

County Rice Elev. _____
 Sec. 3 Twp. 21S Rge. 8W
 Company Sterling Drig. Co.
 Farm Name Humphreys No. 7

TOPS	DEPTH	LOG	DATUM
Anh.			
TP.			
H.			
Tr.			
Dg.			
Bl.			
L.			
K.C.			
B.K.C.			
Ce.			
C.			
M.			
M.			
K.			
Mz.			
Ma.			
V.			
S.			
S.			
A.			
R.			
PE.			
G.			
TD.			

Loc. in Sec. _____

SE SE SW

own or twin?

Geol. _____

Contr. _____

Pool _____

Wherry

<u>1/2 mile</u>	
FIRST REPORT	
<u>JUN 13 1956</u>	
©	

Date Comm. Loc. June 19, 1956

[Large handwritten 'X' mark across the bottom section]

RECEIVED JUN 19 1956

County Rice Elev. 1649 KB
 Sec. 3 Twp. 21S Rge. 8W
 Company Sterling Drlg. Co.
 Name Humphreys No. 1

	DEPTH	LOG	DATUM
H.	<u>2746</u>		
Tr.			
Dg.			
BL.	<u>2885</u>		
L.	<u>2916</u>		
K.C.			
B.K.C.			
Ce.			
C.	<u>3272</u>		
M.	<u>3297</u>		
M.			
K.			
Mz.			
Me.			
V.	<u>3587</u>		
S.	<u>3610</u>		
S.			
A.	<u>3678</u>		
R.			
PE.			
G.			
T.D.	<u>3695</u>		

Loc. in Sec. SE SE SW

Geol. _____

Contr. _____

Pool W.C.

Wherry

COMPLETE

1/2 mile

Date Comm. Loc. June 19, 1956 JUN 20 '56 AUG 15 '56

To C.O. & 1st Gas in C9

MISS. JUN 27 '56 JUL 3 '56 JUL 11 '56

JUL 18 '56 JUL 25 '56 AUG 1 '56 CO 3350

542 @ 3350 AUG 8 '56 CO 32/3220

-80 32/3280-88 9/43" CO

3350 1/2 SIP 980# 9a 530

MCFG PD To Frac. AUG 15 '56

OP F/W 3,210 MCFG RP 710#