

KANSAS

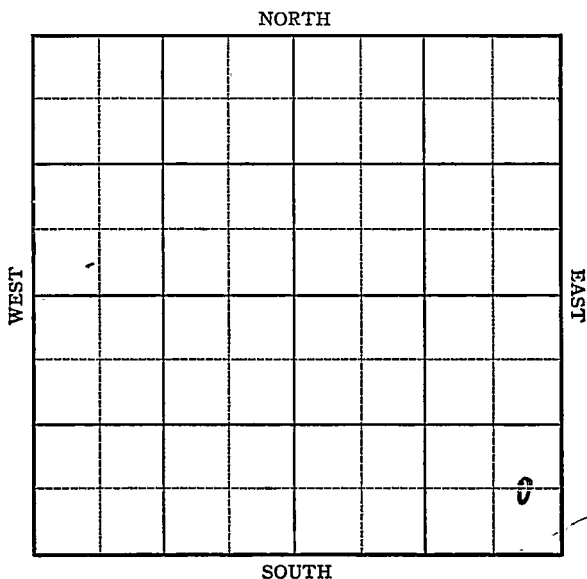
Rice

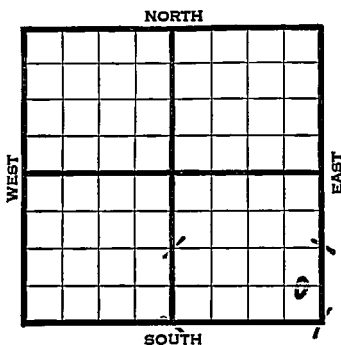
FORM 51 5M 4-41 PETROL

Section 3 Township 21 Range 9-W

Well No. #1 Jeter
~~Vincent~~

Company Ingling & Parker

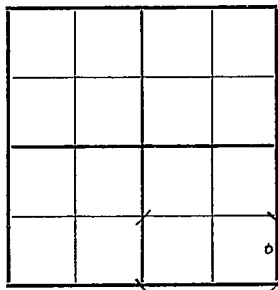


[illegible]

Map No. 17-49 Sec 3 Twp. 21 R 9 WWell No. 1 VincentIngling & Parker CompanyFIRST REPORT Contractor

C E L S E S E

SECTION PLAT

 Ft. from N. Line660 Ft. from S. Line330 Ft. from E. Line Ft. from W. Line

WILDCAT

Location XXRig up

Drilling and Remarks:

RECORD

Cased in., ft.Sand Gas Oil Total Depth

PRODUCTION

1st 24 hrs. Nat. 1st 24 hrs. after shot Gas Cu. Ft.Dry Hole Abandoned

Date

OCT 22 1941 19S. J. LEWIS Scout

Rice

KANSASMap No. K-49 Sec. 3 Twp. 21 R. 9WWell No. 1 JeterIngling & Parker Company

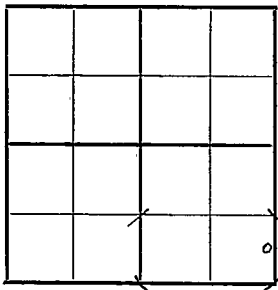
Contractor

C E L S E S E

 Ft. from N. Line660 Ft. from S. Line330 Ft. from E. Line Ft. from W. Line

WILDCAT

SECTION PLAT

Location Rig up

Drilling and Remarks:

Reported as

#1 Vincent

RECORD

Cased in., ft.Sand Gas Oil Total Depth

PRODUCTION

1st 24 hrs. Nat. 1st 24 hrs. after shot Gas Cu. Ft.Dry Hole Abandoned

Date

NOV 28 1941 19 S. J. LEWIS Scout

Rice

KANSAS

Map No. 49 Sec. 3 Twp. 21 R. 9WWell No. 1 JeterIngling & Parker CompanyABANDONED Contractor

C EL SE SE

 Ft. from N. Line660 Ft. from S. Line330 Ft. from E. Line Ft. from W. Line

SECTION PLAT

			o

WILDCAT

Location Rig up

Drilling and Remarks:

*Swamp 3349 1/2**4 AC 3349 1/2**Water.*

RECORD

Cased in., ft.Sand Gas Oil Total Depth 3355

PRODUCTION

1st 24 hrs. Nat. 1st 24 hrs. after shot Gas Cu. Ft.Dry Hole Abandoned

Date

DEC 17 1941

19

S. J. LEWIS Scout