

KANSAS


Form 51-5M-4-36-Palace

Stafford

Section 3 Township 21 Range 11-W

Well Number 1-Siefers

Company Empire

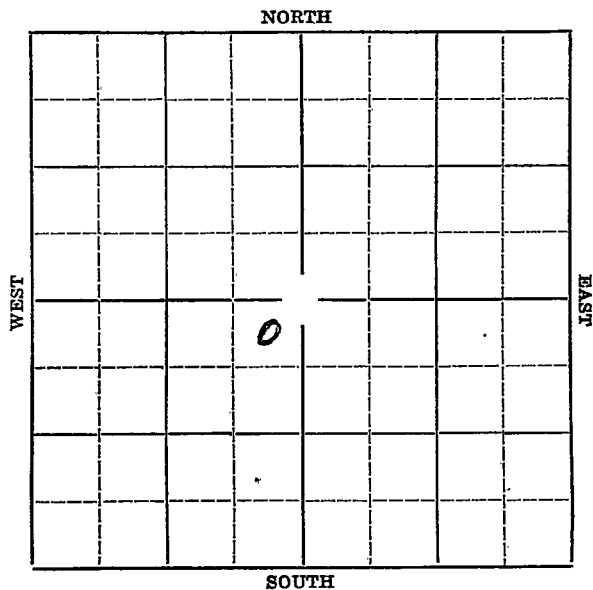

Map No. **KANSAS** Sec. **3** Twp. **21** R. **11-W**  
Well No. **1-Siefers** Farm  
Empire Company


**330** Ft. from N. Line

Ft. from S. Line

**330** Ft. from E. Line

Ft. from W. Line

*Elev. 1776*

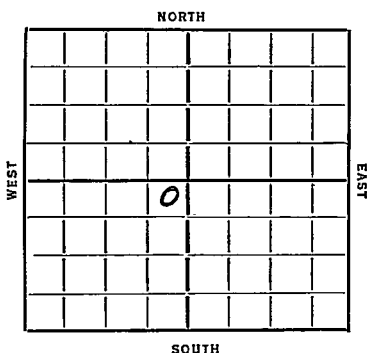

Date  
**1936**

REPORT

|                |                                                                                     |
|----------------|-------------------------------------------------------------------------------------|
| <b>4/22</b>    | Location                                                                            |
| <b>4/30</b>    | --                                                                                  |
| <b>5/7</b>     | Rigging up.                                                                         |
| <b>5/14</b>    | 15" @ 215'. Drlg. 500'.                                                             |
| <b>5/21</b>    | Drlg. 2850'.                                                                        |
| <b>5/28</b>    | Lansing 3066'. 8" @ 3072'. R.W.S.T.                                                 |
| <b>6/4</b>     | --                                                                                  |
| <b>6/11</b>    | H.F.W. 3155-58'. T.D. 3178'. S.D.                                                   |
| <b>6/18</b>    | 3280'. Straight ream.                                                               |
| <b>6/25</b>    | Sil. 3324'. T.D. 3337'. 1800' oil.                                                  |
| <b>7/2</b>     | 325 bbls of oil in 12 hours. Wil<br>Drill deeper.                                   |
| <b>7/9</b>     | T.D. 3343'. Swabb 340 bbls of oil<br>in 24 hours.                                   |
| <b>7/15/36</b> | Sil. 3324'.<br>T.D. 3343'.<br>4000 gallons of acid.<br>533 bbls of oil in 18 hours. |

COMPLETED

KANSAS

Map No. 46 Sec. 3 Twp. 21 R. 11WWell No. 1 SiefersEmpire Company

Contractor

## SECTION PLAT

330 Ft. from N. Line

Ft. from S. Line

330 Ft. from E. Line

Ft. from W. Line

|  |   |  |  |
|--|---|--|--|
|  |   |  |  |
|  |   |  |  |
|  | 0 |  |  |
|  |   |  |  |

## FIRST REPORT

Location ✓

Rig up

Drilling and Remarks:

## RECORD

Cased 1 in.,        ft.

Sand

Gas

Oil

Total Depth

## PRODUCTION

1st 24 hrs. Nat.

1st 24 hrs. after shot

Gas        Cu. Ft.

Dry Hole

Abandoned

Date

APR 22 1936

S. J. LEWIS

192

Scout

Map No. 46 Sec. 3 Twp. 21 R. 11WWell No. 1 SinnerEmpire Company

Contractor

## SECTION PLAT

|  |  |   |  |
|--|--|---|--|
|  |  |   |  |
|  |  |   |  |
|  |  | 0 |  |
|  |  |   |  |

330 Ft. from N. Line

\_\_\_\_\_ Ft. from S. Line

330 Ft. from E. Line

\_\_\_\_\_ Ft. from W. Line

COMPLETED

Location \_\_\_\_\_

Rig up \_\_\_\_\_

Drilling and Remarks:

Sil 3324#000 acid533 8 1/2 15 hrs

## RECORD

Cased \_\_\_\_\_ in., \_\_\_\_\_ ft.

Sand \_\_\_\_\_

Gas \_\_\_\_\_

Oil \_\_\_\_\_

Total Depth 3343

## PRODUCTION

1st 24 hrs. Nat. \_\_\_\_\_

1st 24 hrs. after shot \_\_\_\_\_

Gas \_\_\_\_\_ Cu. Ft.

Dry Hole \_\_\_\_\_

Abandoned \_\_\_\_\_

Date

JUL 10 1936

19

S. J. LEWIS Scout