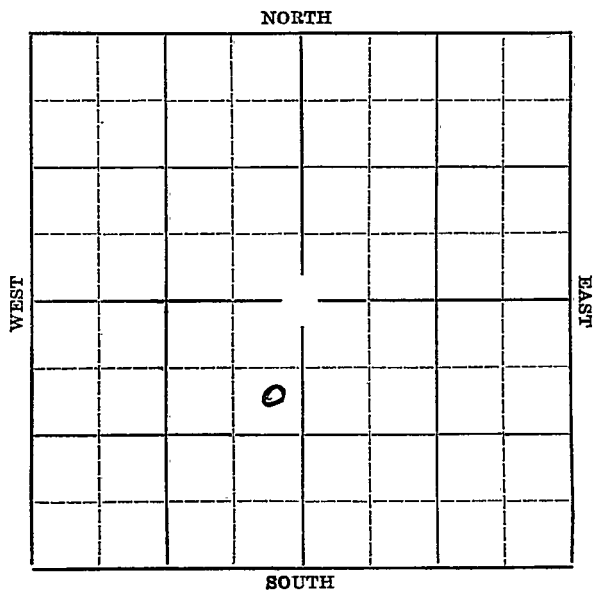


Section 3 Township 21 Range 11-WWell Number #2 SiefersCompany Empire

Stafford

Map No. KANSAS Sec. 5 Twp. 21 R. 11W

Well No. #2 Siefers Farm

Empire

Company

NORTH

990' Ft. from N. Line

Ft. from S. Line

330' Ft. from E. Line

Ft. from W. Line

WEST

EAST

SOUTH

Elev. 1768

Date
1936

REPORT

7/22 Location

7/30 Building rig.

8/6 12" @ 308'. Drlg.

8/13 Drlg. 2084'.

8/20 Drlg. 3040'.

8/27 Simpson 3316'. Siliceous 3326'.

8" @ 3325'. Rigging up stand'd tool

9/3--

9/3/36-Sil. 3325'.

T.D. 3338'.

Potential 193 bbls of oil and 120
bbls of water.

COMPLETED

KANSASMap No. 46 Sec. 3 Twp. 21 R. 11WWell No. 2 Sijers

Company

Contractor

SECTION PLAT

990 Ft. from N. Line

_____ Ft. from S. Line

320 Ft. from E. Line

_____ Ft. from W. Line

Location ✓

Rig up _____

Drilling and Remarks:

RECORD

Cased _____ in., _____ ft.

Sand _____

Gas _____

Oil _____

Total Depth _____

PRODUCTION

1st 24 hrs. Nat. _____

1st 24 hrs. after shot _____

Gas _____ Cu. Ft.

Dry Hole _____

Abandoned _____

Date

JUL 22 1936₁₉S. J. LEWIS Scout

KANSAS

Map No. 46 Sec. 3 Twp. 21 R. 11WWell No. 2 SieversEmpire

Company

Contractor

SECTION PLAT

990 Ft. from N. Line

_____ Ft. from S. Line

330 Ft. from E. Line

_____ Ft. from W. Line

COMPLETED

Location _____

Rig up _____

Drilling and Remarks:

Sl. 3325P. 8 193 oil
120 water

RECORD

Cased _____ in., _____ ft.

Sand _____

Gas _____

Oil _____

Total Depth 3338

PRODUCTION

1st 24 hrs. Nat. _____

1st 24 hrs. after shot _____

Gas _____ Cu. Ft.

Dry Hole _____

Abandoned _____

Date

SEP 9 1936 19

S. J. LEWIS Scout