

KANSAS


Form 51-5M-4-36-Palace

Stafford

Section 3 Township 21 Range 11-W


Well Number #3-Siefers

Company Empire

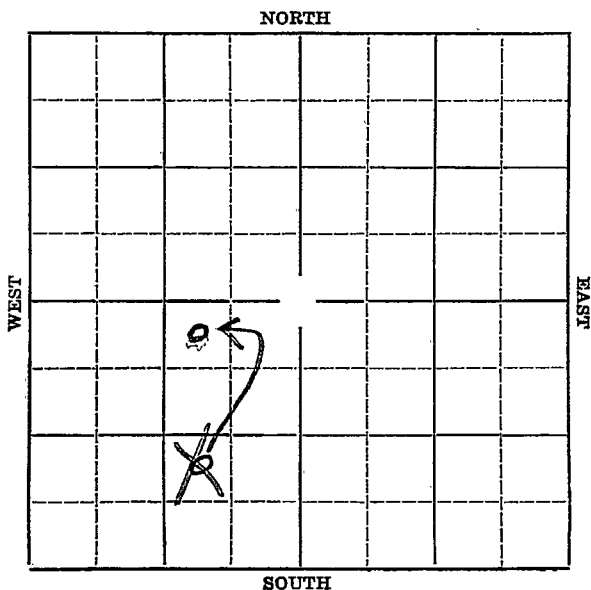

Sec. 3 Twp. 21 R. 11WWell No. #3 Siefers FarmEmpire Company330 Ft. from N. Line~~990~~ Ft. from S. Line990' Ft. from E. Line Ft. from W. Line

Elev. 1767

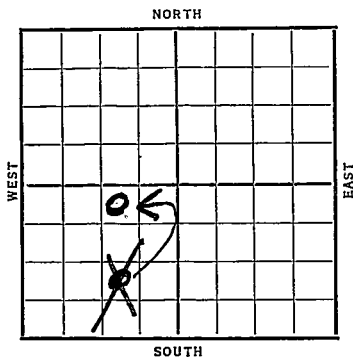

1956	REPORT
8/26	Ponds.
9/3--	12" @ 312'. Waiting on cement.
9/20	Drlg. 2000'.
9/18	Drlg. 3220'.
9/24	Sil. 3348'. 7" @ 3344'. WOC.
10/1	Bailing mud.
10/8	T.D. 3376'. would not take acid.
	Shot 5 qts. Clean out.
10/15	No help. Show oil 3406'.
	T.D. 3426'. fishing.
10/22	2500' water 3457'. Drlg. 3510'.
10/29	Drlg. 3657'.
11/6	3864 Shut down
11/10	Water disposal well
	T. D. 3909
	Take 50 bbls. water per hour.
	REMOVED
	ABANDONED

KANSAS

Map No. 46 Sec. 8 Twp. 21 R. 11WWell No. 3 SienersEmpire Company

Contractor

SECTION PLAT

	O		

 Ft. from N. Line990 Ft. from S. Line990 Ft. from E. Line Ft. from W. Line

FIRST REPORT

Location Rig up

Drilling and Remarks:

Ponds

RECORD

Cased in., ft.Sand Gas Oil Total Depth

PRODUCTION

1st 24 hrs. Nat. 1st 24 hrs. after shot Gas Cu. Ft.Dry Hole Abandoned

Date

AUG 26 1936 19 S. J. LEWIS Scout

KANSAS

Map No. 46 Sec. 3 Twp. 21 R. 11WWell No. 3 SiegessEmpire

Company

Contractor

SECTION PLAT

	29		

330 Ft. from N. Line

_____ Ft. from S. Line

990 Ft. from E. Line

_____ Ft. from W. Line

CORRECTION

Location _____

Rig up _____

Drilling and Remarks:

Reported
NW
488 E 891.

RECORD

Cased _____ in., _____ ft.

Sand _____

Gas _____

Oil _____

Total Depth _____

PRODUCTION

1st 24 hrs. Nat. _____

1st 24 hrs. after shot _____

Gas _____ Cu. Ft.

Dry Hole _____

Abandoned _____

Date

SEP 16 1936

19

S. J. LEWIS Scout

KANSAS

Map No. 46 Sec. 3 Twp. 21 R. 11WWell No. 3. ScifersEmpire Company

Contractor

SECTION PLAT

	0		

380 Ft. from N. Line

_____ Ft. from S. Line

990 Ft. from E. Line

_____ Ft. from W. Line

COMPLETED

Location _____

Rig up _____

Drilling and Remarks:

*Water dip real
well
takes 50 x 8 1/2 water
per hr.*

Dry hole

RECORD

Cased _____ in., _____ ft.

Sand _____

Gas _____

Oil _____

Total Depth 3909

PRODUCTION

1st 24 hrs. Nat: _____

1st 24 hrs. after shot _____

Gas _____ Cu. Ft.

Dry Hole _____

Abandoned 3909

Date

NOV 10 1936₁₉

S. J. LEWIS Scout