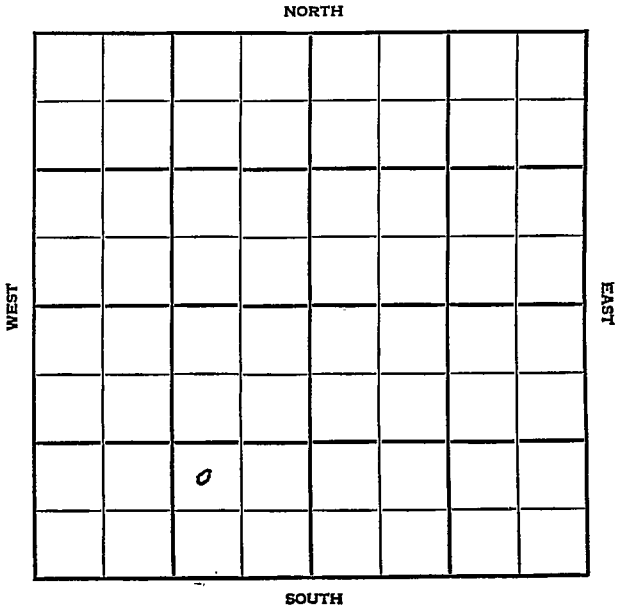


Stafford

KANSAS

DX 78-1

Section 3 Township 21 Range 12WWell No. 1 HeimCompany B & B Drlg.

Stafford KANSAS

SEC.	TWP.	R.
3	21	12W ✓

WELL NO.

1 Heim

FARM

COMPANY

B & B Drlg.

CONTRACTOR

B & B Drlg. -Contr

Chase-Silica Pool

_____ Ft. from N. Line

990


_____ Ft. from S. Line

990

_____ Ft. from E. Line

_____ Ft. from W. Line

NW SE SW

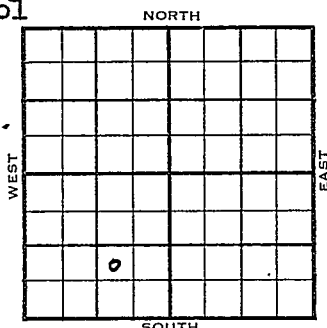

1954

ELEVATION

1853'

REPORT

6/9

Location

Spudding 6-8-54

7/7

Spud 6-8-54 Oil well TD 3483

8" @ 235' Anhy 632' Heeb 3074'

Br. lime 3207' Lans. 3221'

DST 3346-55 open 20 min, rec 6' mud.

Simp. 3457' Arb. 3475'

DST 3448-78 open 40 min, rec 6' OCM

640#

DST 3478-83 open 1 1/4 hr, rec 148' OCM

505# TD 3483 5" @ 3478 CO to 3483

1000 A S/2 BOPH 2500 A S/3 BOPH

Comp. 28 BOPD

COMPLETED

County **Stafford** State **Kansas**

Sec. **3** (Blk. **21** (Sur. **12W** Map No.

Operator **B & B Drlg.**

Well No. **1** Farm **Heim**

Elev.	Location	NW	SE	SW
-------	----------	----	----	----

FIRST REPORT

990	Ft. From	S	Line	SW
-----	----------	---	------	----

990 Ft. From E Line Quarter

1st. Report **JUN. 9 1954**

Completion


Remarks

B & B Drlg. - Contr.

Spudding Date 6-8-54

Drig. Data

J. G. McGEHEE

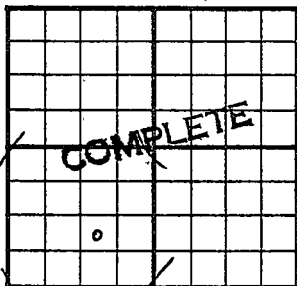County Stafford State KansasSec. 3 (Blk.) 21 (Sur.) 12W Map No.Operator B & B Drlg.Well No. 1 Farm HeimElev. 1853 Location NW SE SW990 Ft. From S Line SW990 Ft. From E Line Quarter

1st. Report

Completion JUL 7 1954Remarks Chase-Silica Pool
B & B Drlg. - Contr.Spudding Date 6-8-54Drlg. Data Oil well TD 34838" @ 235 Anhy 632 Heeb. 3074Br. lime 3207 Lans. 3221 DST 3346-55open 20 min. Rec. 6' mud Simp. 3457Arb. 3475 DST 3448-78 open 40 min.Rec. 6' ocm 640# DST 3478-83 open1 $\frac{1}{4}$ hr. Rec. 148' ocm 505# TD 34835" @ 3478 CO to 3483 1000 AS/ 2 boph 2500 A S/ 3 bophComp. 28 bopd