

Stafford


KANSAS

SECTION 3 TOWNSHIP 21 RANGE 12 W


WELL NO. #6 Wolf

COMPANY Wunderlich & Inger

NORTH

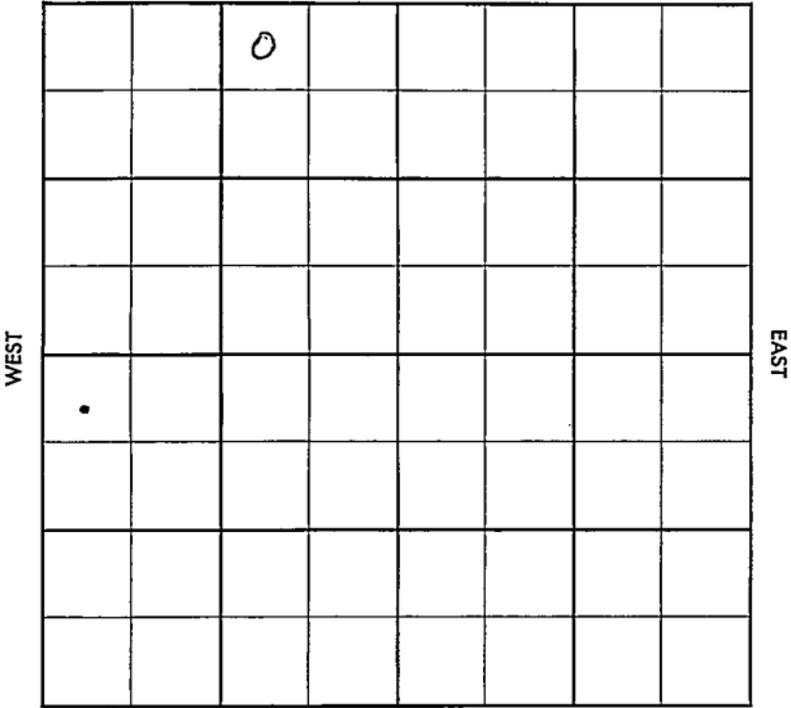

SOUTH

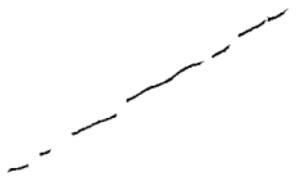

Stafford

KANSAS

SEC. 3	TWP. 21	R.. 12W
-----------	------------	------------

WELL NO.

#6 Wolf

FARM

COMPANY

Wunderlich & Inger

CONTRACTOR

Jackson

Chase-Silica

250 Ft. from N. Line


Ft. from S. Line

1050 Ft. from E. Line

Ft. from W. Line

OF NW/4
~~NW NW NW~~

Appx. NWNENW

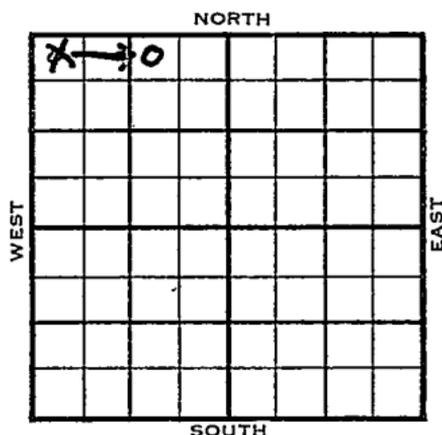

1955	ELEVATION 1849'	REPORT
------	--------------------	--------

12-7 Location

1956

1-18
 Comm. 12-9-55
 8 5/8" @ 227/200
 5 1/2" @ 3403
 DD 3411
 1000 A
 FU 1500' oil
 Comp. 25 bopd
 Anh. 625
 Ft. Riley 1640
 H. 3028
 BL. 3157
 L. 3172
 A. 3402
 TD 3405'

COMPLETED

County Stanford Elev. _____
 Sec. 3 Twp. 21 Rge. 12W
 Company Wunderlich & Inger
 Farm Name Well No. 6

Co.
Lse.
No.
Sec.
T.
R.

TOPS	DEPTH	LOG	DATUM
Anh.			
Tp.			
H.			
Tr.			
Dg.			
Bl.			
L.			
K.C.			
B.K.C.			
Ce.			
C.			
M.			
M.			
K.			
Mz.			
Ma.			
V.			
S.			
S.			
A.			
R.			
PE.			
G.			
T.D.			


Loc. in Sec. ~~N. 1/4 NW~~
APP. NW NENW
1050' FEL of NW 4
250' ENL of NW 4
CORRECTION

Geol. _____
 Contr. _____
Jackson
 Pool _____
Chase-Silica

<u>X</u>	<u>0</u>		

FIRST REPORT
 DEC 7 '55

Date Comm. _____
 Location _____

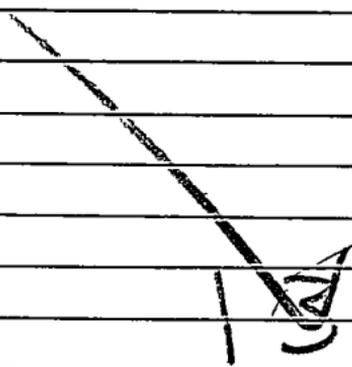

We show a #1-B Rolf at this spot on our maps. Could this be a Twin well, or a workover?

Advise.

Sam

DEC 13 1955

R. G.

County Stafford Elev. 1849
 Sec. 3 Twp. 21 Rge. 12W
 Company Wunderlich & Inger
 Farm Name Wolf No. 6

TOPS	DEPTH	LOG	DATUM	Loc. in Sec.
Anh.	<u>625</u>			NW NE NW
TP. <u>JR Riley</u>	<u>1640</u>			250' NL
H.	<u>3028</u>			1050' EL
Tr.				
Dg.				
Bl.	<u>3157</u>			
L.	<u>3172</u>		<u>1323</u>	Geol.
K.C.				Contr.
B.K.C.				<u>Jackson</u>
Ce.				Pool
C.				<u>Chase-Silica</u>
M.				
M.				
K.				
Mz.				
Ma.				
V.				
S.				
S.				
A.	<u>3402</u>		<u>1553</u>	
R.				
PE.				
G.				
T.D.	<u>3405</u>			

Date Comm. 12-9-55 JAN 18 1956

8 5/8" @ 227/200 5 1/2" @ 3403 DD 3411

1000 A FU 1500' oil Comp, 25 bopd

COMPLETE



JAN 27 1956

R. G.