

Stafford


KANSAS

SECTION 3 TOWNSHIP 21 RANGE 12 W

WELL NO. #7 Wolf

COMPANY Wunderlick & Inger

NORTH

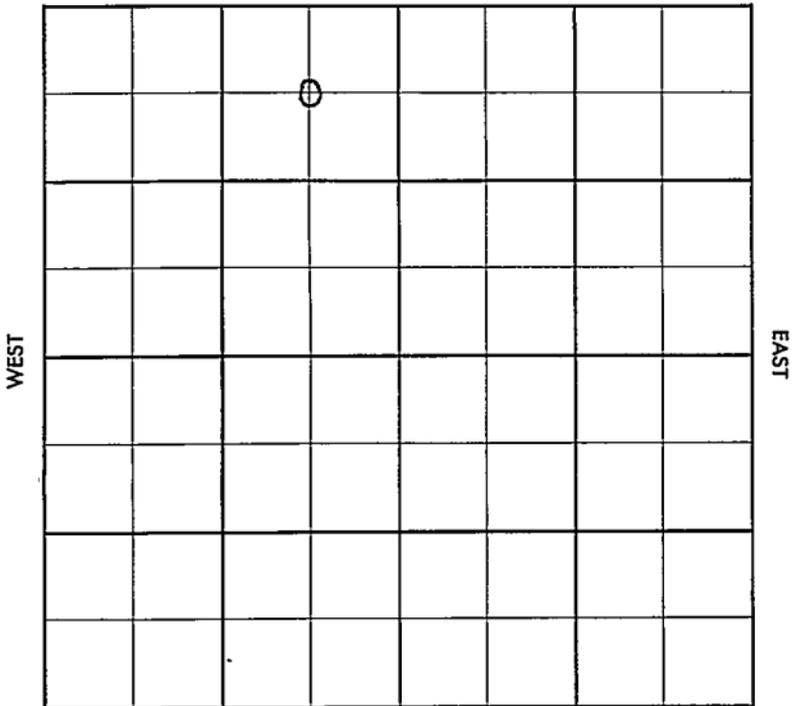

SOUTH

Stafford

KANSAS

SEC. 3	TWP. 21	R. 12W
-----------	------------	-----------

WELL NO.

#7 Wolf

FARM

COMPANY

Wunderlich &amp; Inger

CONTRACTOR

A.L. Jackson

Chase-Silica


650 Ft. from N. Line

Ft. from S. Line

700 Ft. from E. Line

Ft. from W. Line

C NE NW

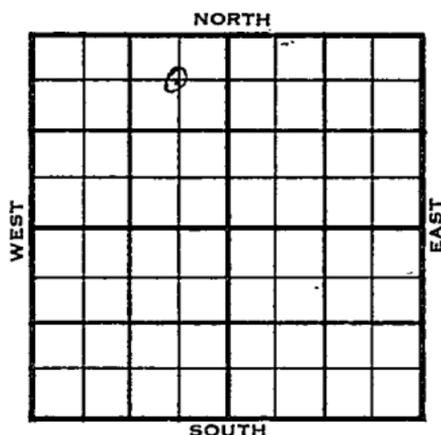

1955	ELEVATION 1857'	REPORT
12-21	MIR	
<u>1956</u>		
1-18	Comm. 12-21-55 8 5/8" @ 201/150 5 1/2" @ 3430 DD 3449 FU 60' oil, 2000 A, FU 475' oil 12 hrs. Comp. 25 bopd H. 3045" BL. 3174 KC 3188 S. Sh. 3414 A. 3429' TD 3435'	
		COMPLETED

County Stafford Elev. \_\_\_\_\_  
 Sec. 3 Twp. 21 Rge. 12W  
 Company Wunderlich & Inger  
 Farm Name Wolf No. 7

TOPS	DEPTH	LOG	DATUM
Anh.			
Top			
H.			
Tr.			
Dg.			
Bl.			
L.			
K.C.			
B.K.C.			
Ce.			
C.			
M.			
M.			
K.			
Mz.			
Mo.			
V.			
S.			
S.			
A.			
R.			
PE.			
G.			
T.D.			

Loc. in Sec. \_\_\_\_\_  
C NE NW  
650' NL  
700' EL  
 Geol. \_\_\_\_\_  
 Contr. \_\_\_\_\_  
A. L. Jackson  
 Pool \_\_\_\_\_  
Chase-Silica


**FIRST REPORT**  
 DEC 21 '55

Date Comm. \_\_\_\_\_  
M I R

*(Large handwritten scribble)*

Co.  
Lse.  
No.  
Sec.  
T.  
R.

County	Stafford	Elev.	1857
Sec.	3	Twp.	21
		Rge.	12W
Company	Wunderlich & Inger		
FarmName	Wolf		No. 7

TOPS	DEPTH	LOG	DATUM	Loc. in Sec.
Anh.				C NE NW
Tr.				650' NL
Dg.				700' EL
Bl.	3174			
L.				Geol.
K.C.	3188		1331	Contr.
B.K.C.				Jackson
Ce.				Pool
C.				Chase-Silica
M.				
M.				
K.				
Mz.				
Mo.				
V.				
S.	sh 3414		1557	
S.				
A.	3429		1572	
R.				
Pe.				COMPLETE
G.				
T.D.	3435			

Date Comm.	12-21-55	JAN 1 8 1956
8 5/8" @ 201/150	5 1/2" @ 3430	DD 3449
FU 60' oil	2000 A	FU 475' oil
12 hr.	Comp. 25 bopd	