

Stafford

Section 30 Township 21 Range 12W

Well No. 2 Fisher "B"

Company Petroleum, Inc.

NORTH

WEST

EAST

SOUTH

0

SOUTH

Stafford KANSAS

SEC.	TWP.	R.
30	21	12W
WELL NO.		
2 Fisher "B"		FARM
COMPANY		
Petroleum, Inc.		
CONTRACTOR		

Garvey

Mueller Pool

330

Ft. from N. Line


Ft. from S. Line

Ft. from E. Line

990

Ft. from W. Line

NE NW NE

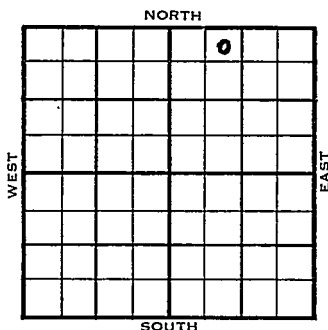

1954

ELEVATION

1866'

REPORT

8/25

Spud 8-20-54

8" @ 326'

Drlg. 2720'

10/6

Spud 8-20-54

Oil Well

TD 3660'

8" @ 326'

Heeb 3124', Br. Lime 3253' Lans 3268'

DST 3273'-3339' opn 1 hr, gas in 8 min
rec 205' O & GCM, 300#

DST 3386'-3400' opn 40 min, rec 5' Mud
Off

DST 3400'-38' opn 1 hr, rec 2530' gas
195' o & gcm, 200# Viola 3496', Simp
3530', Arb. 3582'

DST 3582'-92' opn 1 hr, gas in 31 min
rec 600' oil 775#

DST 3627'-60' opn 1 hr, rec 2100' s.w.
900#

TD 3660'

CO to 3660'

18/ 3586-92

4 1/2" @ 3658'

S/ 3 boph 500 A S/ 10 boph

Comp 264 bopd. 5% Wtr.

County **Stafford** State **Kansas**Sec. **30** (Blk.) **21** (Sur.) **12W** Map No.Operator **Petroleum Inc.**Well No. **2** Farm **Fisher "B"**Elev. **1866** Location **NE NW NE**

					0	

330 Ft. From **N** Line **NE****990** Ft. From **W** Line Quarter1st. Report **AUG 25 1954**

Completion

Remarks

Garvey - Contr.Spudding Date **8-20-54**Drig. Data **Mueller Pool****8" @ 326 drlg. 2720**

FABEN GILSTRAI

County Stafford State Kansas

Sec.	30	(Blk. Twp.)	21	(Sur. Rge.)	12W	Map No.
------	----	----------------	----	----------------	-----	---------

Operator Petroleum Inc.

Well No. 2 Farm Fisher "B"

Elev.	1866	Location	NE NW NE
-------	------	----------	----------

[illegible]

330 Ft. From N Line NE

990 Ft. From W Line Quarter

1st. Report _____

Completion OCT 6 1954

Remarks Mueller Pool

Garvey - Contr.

Spudding Date 8-20-54

Drlg. Data Oil well TD 3660

8" @ 326 Heeb. 3124 Br. lime 3253

Lans. 3268 DST 3273-3339 open 1 hr.

gas in 8 min. Rec. 205' o & gcm 300#

DST 3386-3400 open 40 min. Rec. 5' mud

0# DST 3400-38 open 1 hr. Rec. 2530

gas 195' o & gcm 200# Viola 3496

Simp. 3530 Arb. 3582 DST 3582-92

open 1 hr. gas in 31 min. Rec. 600' oil

775# DST 3627-60 open 1 hr. Rec.

2100' SW 900# TD 3660 GO to 3660

18/ 3586-92 $4\frac{1}{2}''$ @ 3658 S/ 3 boph

500 A S/ 10 boph Comp. 264 bopd 5% wtr

FABEN GILSTRAP