

KANSAS


FORM 51 5M 1-42 PETROL

Stafford

Section 30 Township 21 Range 12-W

Well No. #1 Fischer

Company Nate Appleman etal

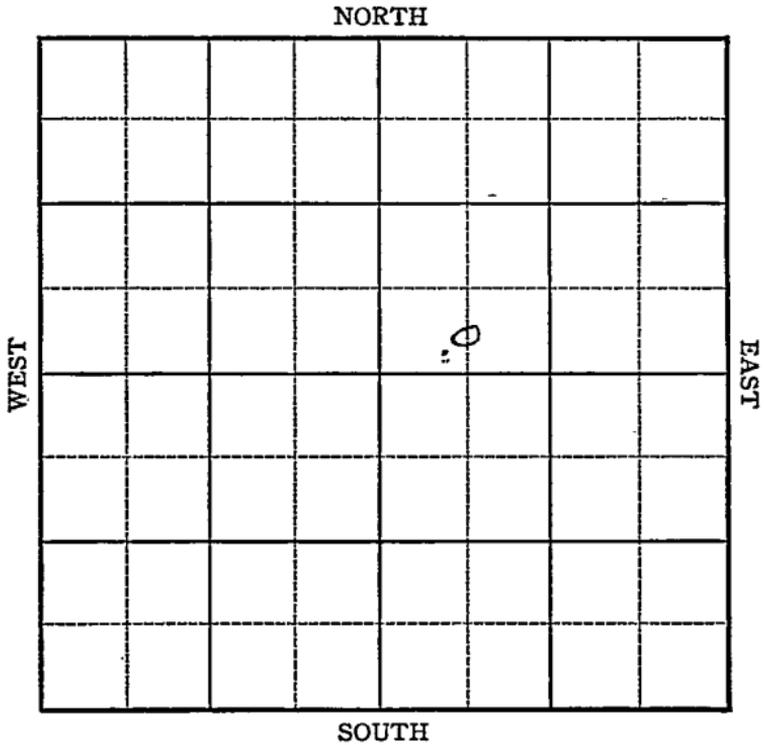

KANSAS

Sec. 30 Twp. 21 R. 12-W

Well No. #1 Fischer Farm

Nate Appleman et al Company

C S L SW NE


_____ Ft. from N. Line

330 _____ Ft. from S. Line

_____ Ft. from E. Line

660 _____ Ft. from W. Line

EN-1865

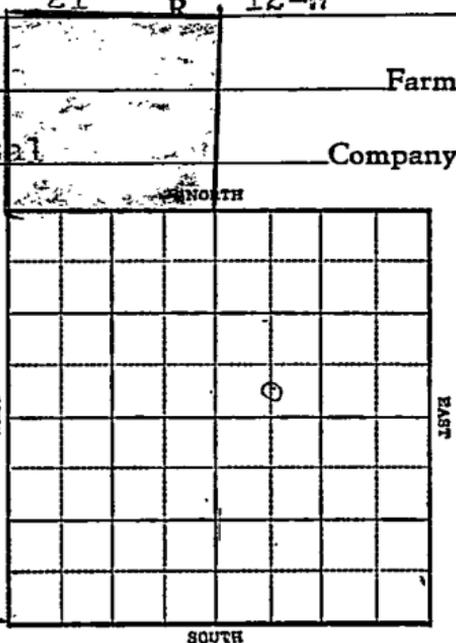

1943

R E P O R T

12-29

Atlantic Farm-out
Location

1944

1-5

"

1/12

"

1/19

"

1/26

"

2-2-

8" at 286'

W O C

2-9

Anhy 680'

Drlg. 2395'

2/23

Arb 3661-84 TD SO

5" @ 3664 Rust

3/1

TD 3685

3/7

3685-79 TD

Simp 3649

Arb 3655-79 TD

1000 acid

Drilled to 3389

TD water.

3/15

" "

3/22

" "

3/29

TD "

4/5

" "

4/12

" "

OVER

1944

4/19

Plug 3657

59 shots 3624-35 No shows

60 shots 3635-47

5 gal water per hr-1000 acid.

4/26

5" @ 3664

Arb 3661

TD 3684

ABANDONED

KANSAS / 6
 Map No. 6 Sec. 30 Twp. 21 R. 12W

Well No. 1 Fischer


Nate Appleman et al. Company

FIRST REPORT

Contractor

C S L SW NE

SECTION PLAT

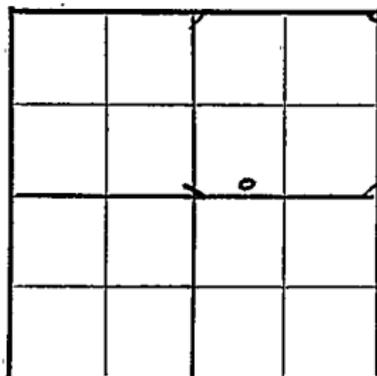

_____ Ft. from N. Line

330

_____ Ft. from S. Line

_____ Ft. from E. Line

660

_____ Ft. from W. Line

Wildcat

Location X

Rig up _____

Drilling and Remarks:

Atlantic
 farm-out

RECORD

Cased _____ in., _____ ft.

Sand _____

Gas _____

Oil _____

Total Depth _____

PRODUCTION

1st 24 hrs. Nat. _____

1st 24 hrs. after shot _____

Gas _____ Cu. Ft.


Dry Hole _____

Abandoned _____

Date

DEC 29 1943 19

S. J. LEWIS Scout

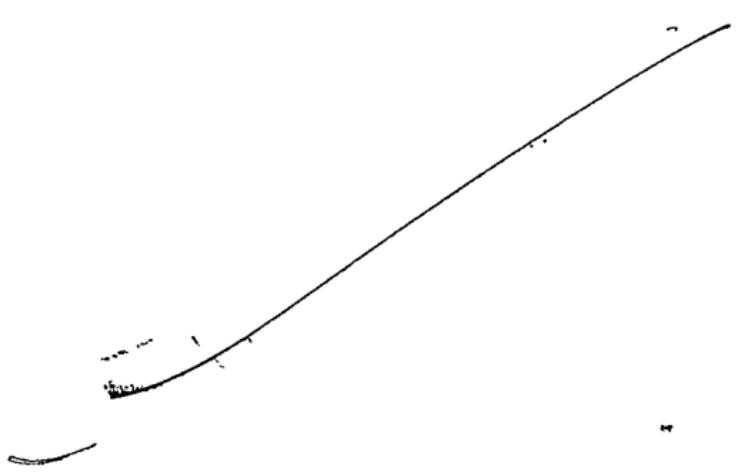

Handwritten scribble

Misc. Small Maps	<i>Orma</i>
Cards	<i>Mudge</i>
Tracing	<i>Mudge</i>
France Map	<i>[Signature]</i>
Scarborough Map	<i>[Signature]</i>
Moody Map	<i>[Signature]</i>
Geological Dept.	
Moody Plat Book	

Misc. Small Maps

Cards

Tracing

France Map

Scarborough Map

Moody Map

Geological Dept.

Moody Plat Book

Handwritten notes and signatures:
Dana
Madge
M.E.S.
M.E.S.
M.E.S.