


Section 30 Township 21 Range 13W

Well No. #1 Brown "C"

Company Petroleum, Inc.

NORTH

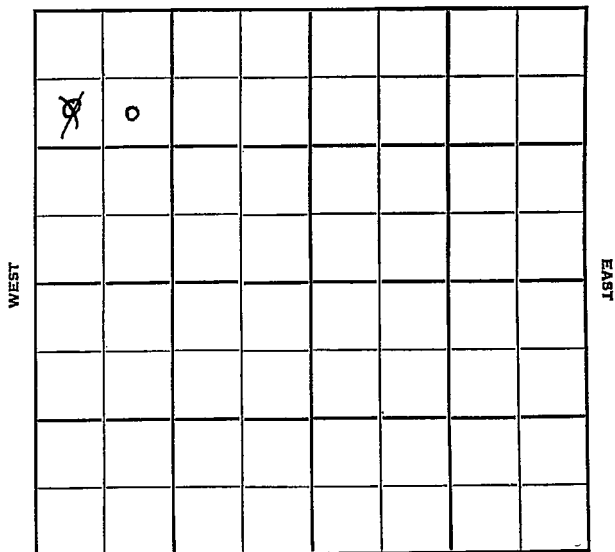

SOUTH


Sec. 30 Twp. 21 R. 13-W

Well No. #1 Brown "C" Farm _____

Petroleum Inc. Company _____

Garvey Oil Contractor _____

990 Ft. from N. Line
 _____ Ft. from S. Line
 _____ Ft. from E. Line
330 990 Ft. from W. Line

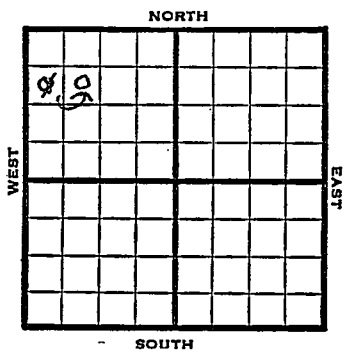

SW NW NW
SE

1950 Elev 1921' REPORT

12/13 Spud 12-9-50
 8" @ 193
 Anhy 812
 Drlg 890'

1951
 1/24 8" @ 193
 Anhy 812 Heeb 3251
 Br line 3371 Lans 3382
 Cong 3630 Viola 3635
 Simp 3668 Arb 3721-71
 5" @ 3770
 6/3754-56 150 A
 2400' water
 500' oil 3/3740-41 100 A
 15/3738-43, 250 A
 20 boph
 Comp 451 bopd 12% water
 Completed TD 3771'

COMPLETED

County Stafford State Kansas

Sec. 30 (Blk. Twp.) 21 (Sur. Rge.) 13W Map No.

Operator Petroleum Inc.

Well No. 1 Farm Brown #0

Elev. 1921 Location SW NW NW

0					

990 Ft. From N Line NW

330 Ft. From W Line Quarter

1st. Report DEC 13 1950

Completion _____

Remarks _____

Garvey Oil - Contr.

Spudding Date 12-9-50

Drlg. Data _____

8" @ 193 Any 812 drlg. 890

Kansas

Map No. _____ Sec. 30 Twp. 21 R. 13W

Well No. 1 Brown "C"

_____ Petroleum Inc. _____ Company

_____ **CORRECTION** _____ Contractor

SE NW NW

SECTION PLAT

990 Ft. from N. Line

_____ Ft. from S. Line

_____ Ft. from E. Line

990 Ft. from W. Line

0			

Stafford County

Location _____

Rig up _____

Drilling and Remarks:

Reported

SW NW NW

RECORD

Cased _____ in., _____ ft.

Sand _____

Gas _____

Oil _____

Total Depth _____

PRODUCTION

1st 24 hrs. Nat. _____

1st 24 hrs. after shot _____

Gas _____ Cu. Ft.

Dry Hole _____

Abandoned _____

Date

DEC 2 1949

J. E. TYRA Scout


County Stafford State Kansas

Sec. 30 (Blk. 21 (Sur. 13W (Twp. 21 (Rge. 13W Map No.

Operator Petroleum Inc.

Well No. 1 Farm Brown "C"

Elev. 1921 Location SE NW NW

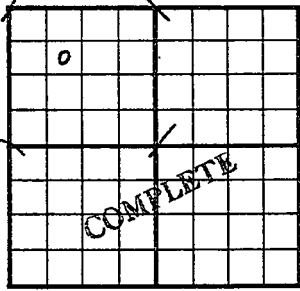

990 Ft. From N Line NW

990 Ft. From W Line Quarter

Ist. Report

Completion JAN 24 1951

Remarks

Garvey Oil - Contr.

Spudding Date 12-9-50

Drilg. Data Oil well TD 3771

8" @ 193 Anhy 812 Heeb. 3251

Br. lime 3371 Lans. 3382 Cong. 3630

Viola 3635 Simp. 3668 Arb. 3721-71

5" @ 3770 6/ 3754-56 150 A 2400' water

500' oil 3/ 3740-41 100 A 15/ 3738-43

250 A 20 boph Comp. 451 bopd 12% water

J. E. TYRA