


Section 30 Township 21 Range 13W

Well No. #5 Brown "G"

Company Petroleum Inc.

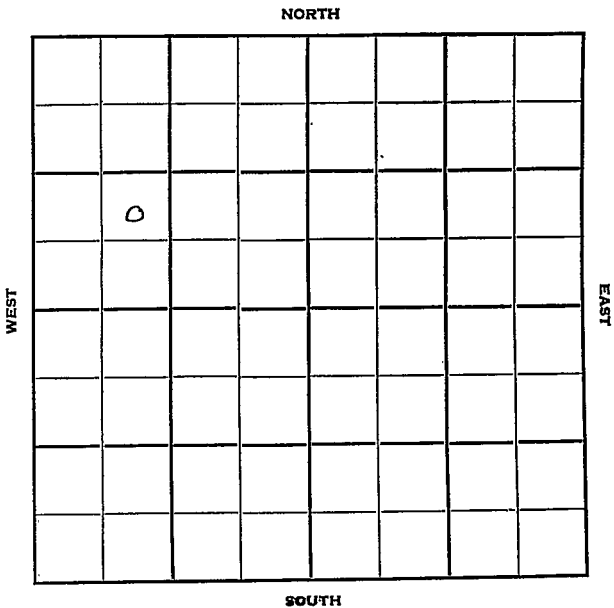

Stafford KANSAS

Sec. 30 Twp. 21 R. 13 W

Well No. # 5 Brown "G" Farm

Petroleum Inc. Company

Garvey Oil Contractor

Pundsack Pool


 Ft. from N. Line

990 Ft. from S. Line

 Ft. from E. Line

990 Ft. from W. Line

NE SW NW

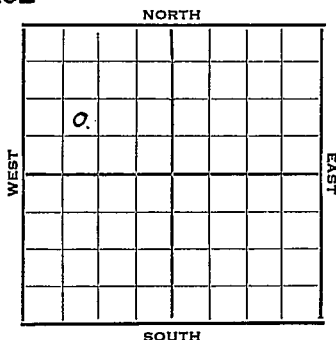


1951 Elev. 1922' REPORT

12/5 Spud 12-3-51
8" @ 206'

12/19 Spud 12-3-51
D & A TD 3764' 8" @ 206
Heeb 3254' Br. lime 3376'
KC 3386' Cong. 3633' Viola 3638'
Simp. 3687' Arb. 3739'
DST 3740-43 open 1 hr. rec 2' mud
DST 3742-49 open 1 hr. rec 8' mud
DST 3739-54 open 1 hr. rec 20' mud
TD 3764' D & A

ABANDONED

J. E. TYRA

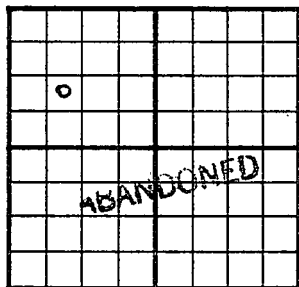County Stafford State KansasSec. 30 (Blk. Twp.) 21 (Sur. Rge.) 13W Map No.Operator Petroleum Inc.Well No. 5 Farm Brown "C"Elev. 1922 Location NE SW NW990 Ft. From S Line NW990 Ft. From W Line QuarterIst. ReportCompletion DEC 1 9 1951Remarks Pundsack PoolGarvey Oil - Contr.Spudding Date 12-3-51Drlg. Data D & A TD 37648" @ 206 Heeb. 3254 Br. lime 3376KC 3386 Cong. 3633 Viola 3638Simp. 3687 Arb. 3739 DST 3740-43open 1 hr. Rec. 2' mud DST 3742-49open 1 hr. Rec. 8' mud DST 3739-54open 1 hr. Rec. 20' mud TD 3764D & A

J. E. TYRA