

DX 78-1

Stafford

KANSAS

30

21


14W

Section _____ Township _____ Range _____

Well No. #1 Bruster

Company Rex-Morris & CRA

NORTH

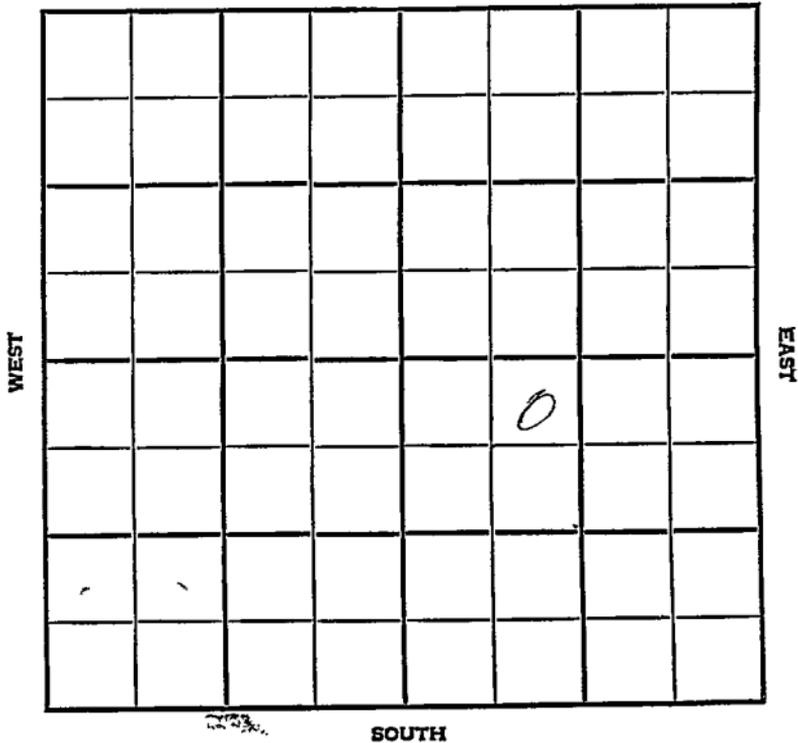

SOUTH

County Stafford Elev. 1951 DF
 Sec. 30 Twp. 21 Rge. 14W
Rex-Morris & CRA
Braster No. 1

GPS	DEPTH	LOG	DATUM
Anh			
Top	2940	2941	
H.	3307	3304	
Tr.	3325	3328	
Dg.	3347	3345	
Bl.	3420	3420	
L.	3434	3433	
K.C.			
B.K.C.			
Ce.			
C.			
M.			
M.			
K.			
Mz.			
Mo.			
V.	3695	3695	
S. <i>SD</i>	3739?	3761	
S. <i>sd</i>	3750	3774-87	
A.	3812	3813	
R.			
PE.			
G.			
T.D.	3840		

Loc. in Sec. NE NW SE
 Geol. _____
 Contr. _____
Rex-Morris Tool
Lincoln
Wildcat
ABANDONED
 OCT 31 '56
Kimmitt

Date Comm. Spd. 10-19-56 NCRA (FO)
MIRT OCT 24 '56 10-19-56 P 5/8 271
1200 @ 2385 OCT 31 '56 DST 3695
-3740 1hr 20' Md 1711 press
0/20" DST 3740-95 over 1hr 550'
MW FR 140-400 BHP 1120/20"

DEA