


Section 30 Township 21 Range 15W

Well No. 1 Vratil

Company M.B. Armer

Wildcat
NORTH

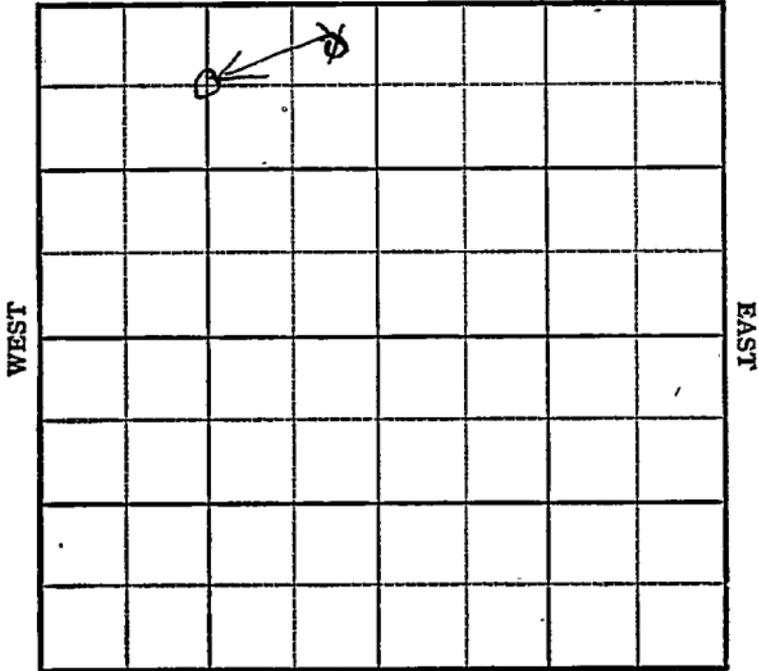

SOUTH

Sec. 30 Twp. 21 R. 15W ✓

Well No. 1 Vratil Farm

M.B. Armer Company


Wildcat

330 Ft. from N. Line

_____ Ft. from S. Line

1320
330 Ft. from E. Line

_____ Ft. from W. Line

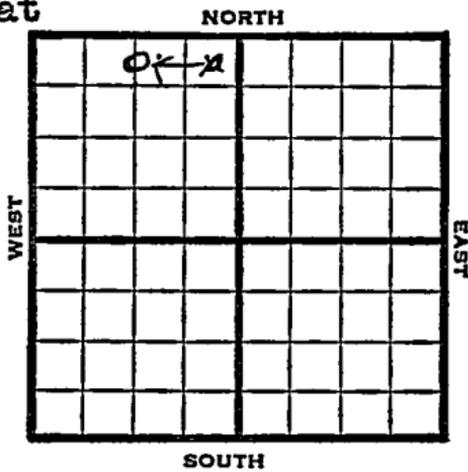

~~NE NW~~ EN & NW

1948 Eli 1967' REPORT

11/17	8" @ 944'
	Anhy 940'
11/23	Drlg 2830'
11/30	Lansing 3484'
	BKC 3736'
	Simpson 3850'
	Drlg 3885'
12/8	Arb 3905'
	TD 3955'
	Aband.
	ABANDONED

Map No. _____ Sec. 30 Twp. 21 R. 15W

Well No. 1 Vratil

M. B. Armer Company

FIRST REPORT

Contractor

NE NW


SECTION PLAT

330 Ft. from N. Line

_____ Ft. from S. Line

330 Ft. from E. Line

_____ Ft. from W. Line

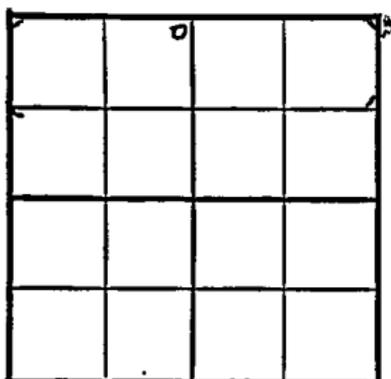

Pawnee County

Location _____

Rig up _____

Drilling and Remarks:

8" @ 944

Anhy 940

RECORD

Cased _____ in., _____ ft.

Sand _____

Gas _____

Oil _____

Total Depth _____

PRODUCTION

1st 24 hrs. Nat. _____

1st 24 hrs. after shot _____

Gas _____ Cu. Ft.

Dry Hole _____

Abandoned _____

Date

NOV 17 1948

19

S. J. LEWIS Scout

Map No. 82 Sec. 30 Twp. 21 R. 15W

Well No. 1 Vratil

M. B. Armer Company

CORRECTION Contractor

C N L NW

SECTION PLAT

330 Ft. from N. Line

_____ Ft. from S. Line

1320 Ft. from E. Line

_____ Ft. from W. Line

	0		

PAWNEE

Location _____

Rig up _____

Drilling and Remarks:

Reported
NE NW

RECORD

Cased _____ in., _____ ft.
 Sand _____
 Gas _____
 Oil _____
 Total Depth _____

PRODUCTION

1st 24 hrs: Nat. _____
 1st 24 hrs. after shot _____
 Gas _____ Cu. Ft.
 Dry Hole _____
 Abandoned _____

Date

DEC 1 1948 19

S. J. LEWIS Scout

Map No. 82 Sec. 30 Twp. 21 R. 15W

Well No. 1 Vratil

M. B. Armer Company

ABANDONED

Contractor

C N L NW

E. 1967

SECTION PLAT

330 Ft. from N. Line

_____ Ft. from S. Line

1320 Ft. from E. Line

_____ Ft. from W. Line

⊕			

Pawnee County

Location _____

Rig up _____

Drilling and Remarks:

CR 53905

RECORD

Cased _____ in., _____ ft.

Sand _____

Gas _____

Oil _____

Total Depth 2200

PRODUCTION

1st 24 hrs. Nat. _____

1st 24 hrs. after shot _____

Gas _____ Cu. Ft.

Dry Hole _____

Abandoned _____

Date

DEC 8 1948 19

S. J. LEWIS Scout