


Section 30 Township 21 Range 11W

Well No. #1 Duggan

Company Vickers Pet.

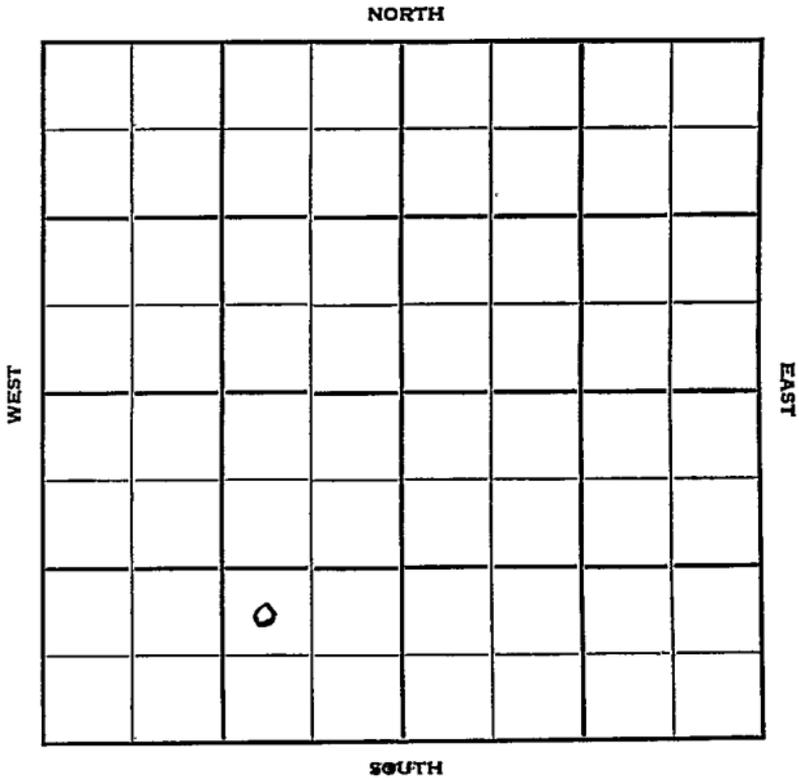

Sec. 30 Twp. 21 R. 11 W

Well No. # 1 Duggan Farm

Vickers Pet. Company

Contractor

Duggan


Ft. from N. Line

990 Ft. from S. Line

990 Ft. from E. Line

Ft. from W. Line

NW SE SW

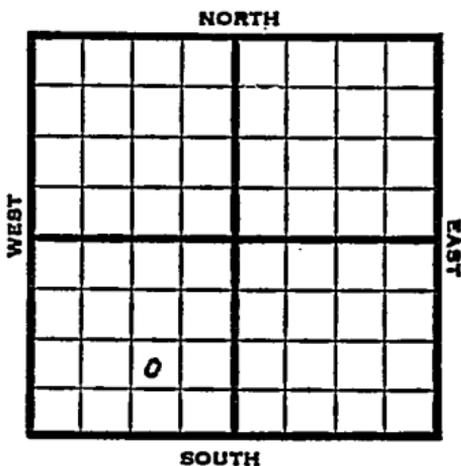

1951

Elev. 1777' REPORT

2/21 Spud 2-20-51

4/11 Spud 2-20-51  
Oil Well TD 3557  
8" @ 280

Heeb. 3038' Br Lime 3168

Lans. 3185' BKC 3426

Cong. 3451 Viola 3466

DST 3465-75 opn 15 min.

Rec. 7' mud SSO 3499-3503

Simp sh 3482 Simp sand 3499

DST 3498-3513 opn 17 min

Rec. 210' ocm

Arb. 3526-31 TD 5" @ 3527

CO to 3531 FU 20' oil DD 3538

FU 50' oil DD 3557 FU 115' oil

14 hr. 1000 A S/3/4 boph

3000 A FU 1050' fluid 450' wtr

600' oil S/3 1/2 bph 35% wtr

PB 3521 24/3496-3502 no inc.

16/3604-08 16/3501-05

S/2 1/2 boph FU 1600' oil 14 hrs.

Comp. 44 bopd

**COMPLETED**



