


Section 30 Township 21 Range 11 W

Well No. # 3 Duggan

Company Picknell Drlg.

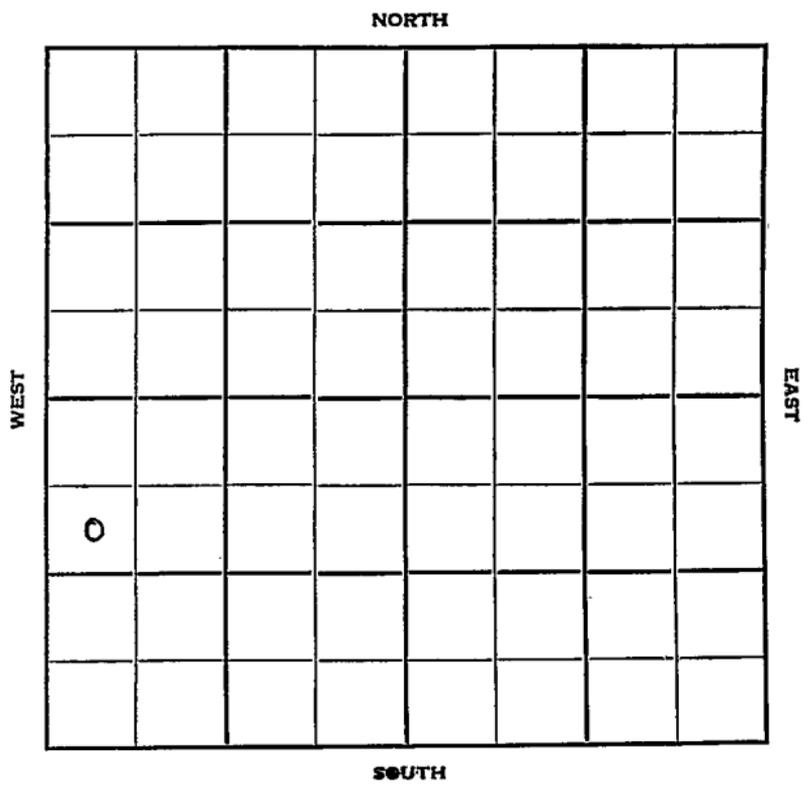

Sec. 30 Twp. 21 R. 11 W ✓

Well No. # 3 Duggan Farm

Picknell Drlg. Company

Contractor

Duggan Pool


990 Ft. from N. Line

\_\_\_\_\_ Ft. from S. Line

\_\_\_\_\_ Ft. from E. Line

330 Ft. from W. Line

SW NW SW

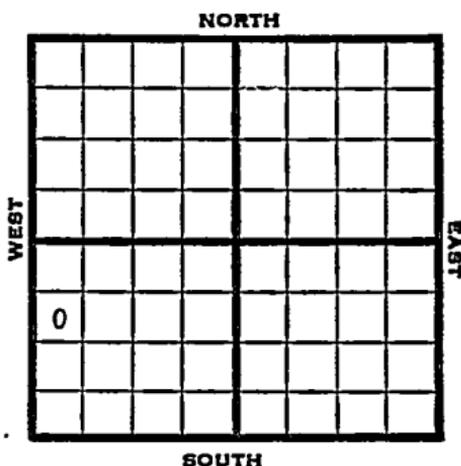

1951

Elev. 1793' REPORT

7/11

Spud 7-9-51  
10" @ 241' WOC

9/19

Spud 7-9-51  
Oil Well TD 3536  
10" @ 241  
Heeb. 3045 Br line 3175  
Lans. 3190  
DST 3324-45 opn 1/2 hr  
Rec. 15' mud Cong. 3470  
DST 3470-3511 opn 20 min.  
Rec. 330' hgcm Simp 3497  
Arb. 3516  
DST 3515-21 opn 1hr  
Rec. 32' o & gcm TD 3525  
5" @ 3516 GO to 3523  
DD 3536 500 A S/2 boph  
1500 A Comp. 22 bopd  
2% wtr.

**COMPLETED**

County Stafford State Kansas

Sec. 30 (Blk. Twp.) 21 (Sur. Rge.) 11W Map No.

Operator Picknell Drig.

Well No. 3 Farm Duggan

Elev. \_\_\_\_\_ Location SW NW SW


990 Ft. From N Line SW

330 Ft. From W Line Quarter

1st. Report JUL 11 1951

Completion \_\_\_\_\_

Remarks \_\_\_\_\_

Spudding Date 7-9-51

Drig. Data Duggan - pool

10" @ 241' W.O.C.

J. E. TYRA

