


Stafford

Map No. 14-NSAS Sec. 30 Twp. 21 R. 11W

Well No. 1- Evans Farm
Kessler & Their Company

330 Ft. from N. Line
Ft. from S. Line
330 Ft. from E. Line
Ft. from W. Line

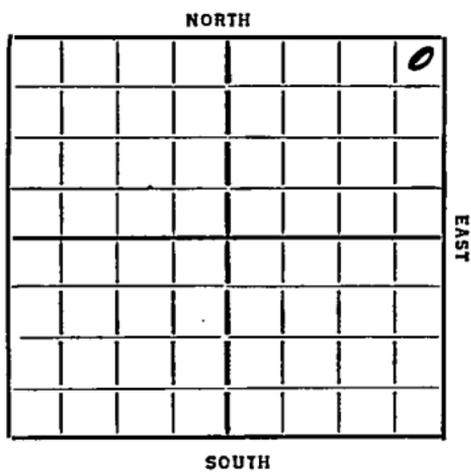

Elev. 1763

REPORT

~~1936~~
 2/19 Location
 2/28 Cap Rot
 3/6
~~3/13 Est. 1 1/2 in. gas 2950-40 T.D. 2940
 Running 8"~~
 3/13 —
 3/20 12"-243 Drlg. 1625
 3/27 Drlg. 2520'
 4/2 Top & Topeka 2630' Drlg. 3075'
 4/10 Vida 3525'-42' S.D. 3550'
 4/15 Sil 3607
 TD 3667
 D + A.

ABANDONED

Map No. 46 Sec. 30 Twp. 21 R. 11W

Well No. 1 - Evans

Kessler & Their Company

Contractor

FIRST REPORT

SECTION PLAT

330 Ft. from N. Line

Ft. from S. Line

330 Ft. from E. Line

Ft. from W. Line

			0

Location

Rig up

Drilling and Remarks:

RECORD

Cased _____ in., _____ ft.

Sand _____

Gas _____

Oil _____

Total Depth _____

PRODUCTION

1st 24 hrs. Nat. _____

1st 24 hrs. after shot _____

Gas _____ Cu. Ft.

Dry Hole _____

Abandoned _____

Date

2-19-36 192

ORVAL MANN SCHRECK

Scout

Map No. 46 Sec. 30 Twp. 21 R. 11W

Well No. 1 Evens

Kessler & Their Company

Contractor

SECTION PLAT

330 Ft. from N. Line

..... Ft. from S. Line

330 Ft. from E. Line

..... Ft. from W. Line

ABANDONED

			0

Location.....

Rig up.....

Drilling and Remarks:

Sci 3607

RECORD

Cased..... in., ft.

Sand.....

Gas.....

Oil.....

Total Depth... 3667

PRODUCTION

1st 24 hrs. Nat.....

1st 24 hrs. after shot.....

Gas..... Cu. Ft.

Dry Hole.....

Abandoned.....

Date

APR 15 1936