


Section 30 Township 21 Range 11 W

Well No. #1 Hullman

Company North American Producing

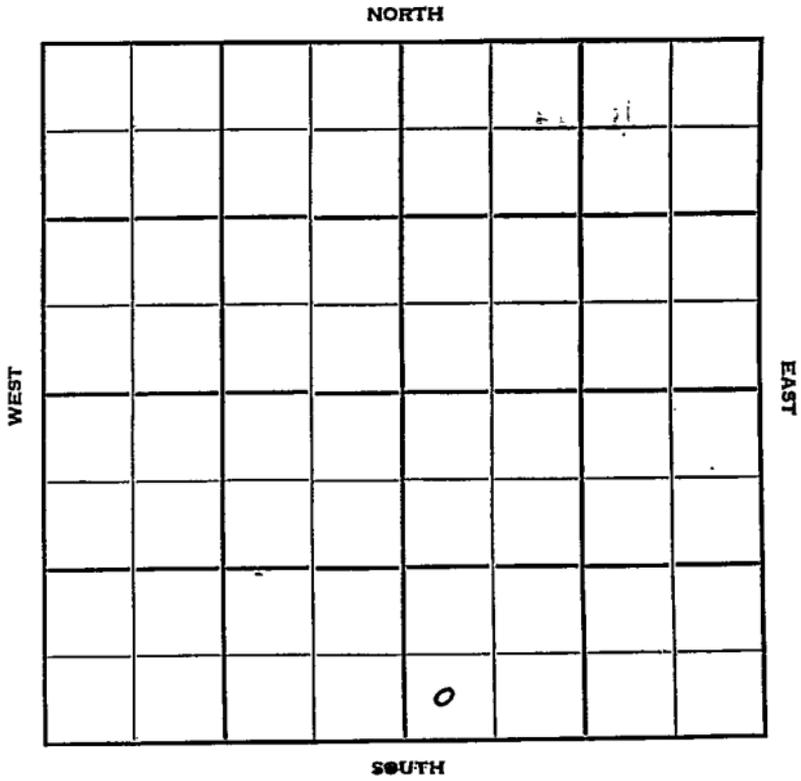

Stafford

Sec. 31 30 Twp. 21 R. 11W

Well No. #1 Hullman Farm

North American Producing Company

Harbar Drlg. - Contr. Contractor

Dugan Pool


Ft. from N. Line

330' Ft. from S. Line

Ft. from E. Line

330' Ft. from W. Line

SW SW SE

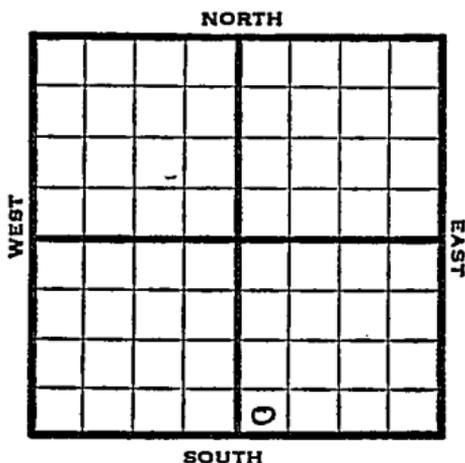

1951

Elev. 1770' REPORT

1/17

4/4

Location
 Spud 1-18-51
 Oil Well TD 3514
 8" @ 200'
 Heeb. 3030 Br Lime 3162
 Ians. 3180 Cong. 3450
 Viola 3469'
 DST 3470-78 opn 1/2 hr
 Rec. 15' mud
 Simp sh 3486' Sand 3503
 DST 3503-14 opn 15 min
 Rec. 90' hocm 480' oil
 20' water 5" @ 3506
 TD 3514
 FU 1450' oil S/6 boph
 Comp. 282 bopd

COMPLETED

Map No. _____ Sec. 30 Twp. 21 R. 11W

Well No. 1 Hullman

North American Producing Company
CORRECTION

Contractor _____

SW SW SE

SECTION PLAT

_____ Ft. from N. Line

330 Ft. from S. Line

_____ Ft. from E. Line

330 Ft. from W. Line

		o	

Stafford County

Location _____

Rig up _____

Drilling and Remarks:

Reported

31-21-11W

RECORD

Cased _____ in., _____ ft.

Sand _____

Gas _____

Oil _____

Total Depth _____

PRODUCTION

1st 24 hrs. Nat. _____

1st 24 hrs. after shot _____

Gas _____ Cu. Ft.

Dry Hole _____

Abandoned _____

Date

JAN 24 19

19

J. E. TYRA

Scout

