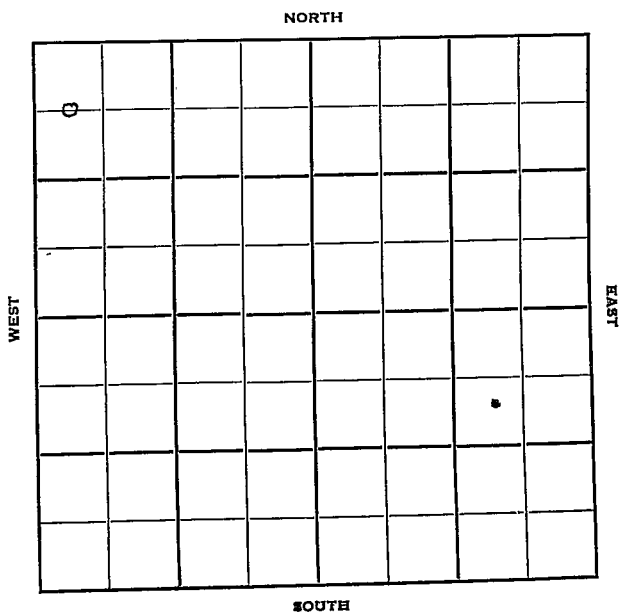


Section 30 Township 21 Range 11-WWell No. #1 McMillanCompany Aladdin Pet.

Stafford KANSAS

Sec. 30 Twp. 21 R. 11W ✓

Well No. #1 McMillan Farm

Aladdin Pet. Company

Fernell Contractor

Sand Hill


660' Ft. from N. Line

Ft. from S. Line

Ft. from E. Line

330' Ft. from W. Line

C W/2 NW NW

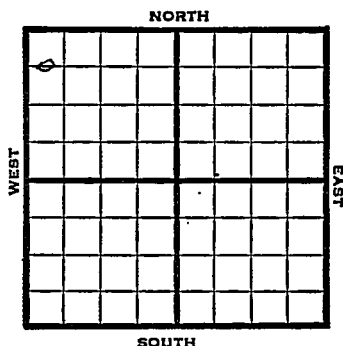

1950 Elev 1813 REPORT

5/31 Location
7/12 8 5/8" @ 250

Anhy 568

Heeb 3070

Br lime 3173

Lans 3212

DST 3239-3310, opn 1 hr rec 60' mud

Cong 3490

Arb 3565

DST 3568-70 opn 1 hr rec 45' mud SS0

TD 3620

D&A

ABANDONED


Map No. _____ Sec. 30 Twp. 21 R. 11WWell No. 1 McMillanAladdin Pet. CompanyFernell ContractorC W/2 N^W NW

SECTION PLAT

660 Ft. from N. Line

_____ Ft. from S. Line

_____ Ft. from E. Line

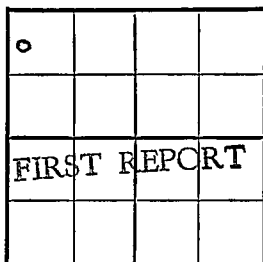330 Ft. from W. LineStaffordLocation X

Rig up _____

Drilling and Remarks: _____

RECORD

Cased _____ in., _____ ft.

Sand _____

Gas _____

Oil _____

Total Depth _____

PRODUCTION

1st 24 hrs. Nat. _____

1st 24 hrs. after shot _____

Gas _____ Cu. Ft.

Dry Hole _____

Abandoned _____

Date

MAY 24 1919 J E TYRA Scout

Kansas

Map No. _____ Sec. 30 Twp. 21 R. 11WWell No. 1 McMillanAladdin Pet.

Company _____


Contractor _____

C W L NW NW

E1. 1813
SECTION PLAT.660 Ft. from N. Line

_____ Ft. from S. Line

_____ Ft. from E. Line

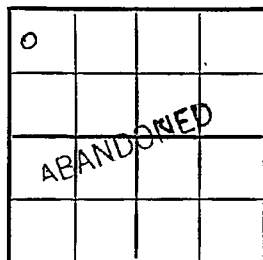330 Ft. from W. Line

Stafford County

Location _____

Rig up _____

Drilling and Remarks:

8 5/8" C 250

Anky 568

Heeb. 3070

Br. line 3173.

Lans. 3212

DST 3239-3310

RECORD

Cased _____ in., _____ ft.

Sand _____

Gas _____

Oil _____

Total Depth 3620

PRODUCTION

1st 24 hrs. Nat. _____

1st 24 hrs. after shot _____

Gas _____ Cu. Ft.

Dry Hole _____

Abandoned _____

Date

JUL 12 1950 19

J. E. TYRA

Scout

1. N. 1/4
 2. N. 1/4
 3. N. 1/4
 4. N. 1/4

Scout Cards	
Land Small Map	
Land Wall Map	
Tracings	
France Map	
Pierce Map	
Misc.	

open 1 hr.
 Rec. 60' mud
 Cong. 3490
 Arb. 3565
 DST 3568-70
 open 1 hr.
 Rec. 45' mud
 TD 3620

1250
 1250
 1250