


Section 30 Township 21 Range 28W

Well No. 1 John Bly

Company Sinclair-Prairie

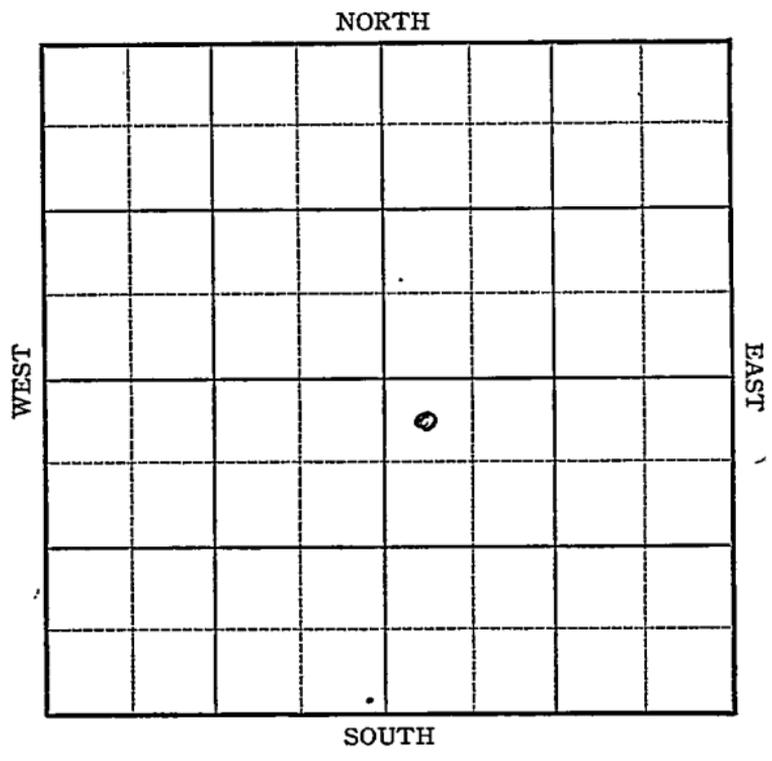

Sec. 30 Twp. 21 R. 28W

Well No. #1 John Bly Farm

Sinclair-Prairie Company


Wildcat

330 Ft. from N. Line

\_\_\_\_\_ Ft. from S. Line

\_\_\_\_\_ Ft. from E. Line

330 Ft. from W. Line

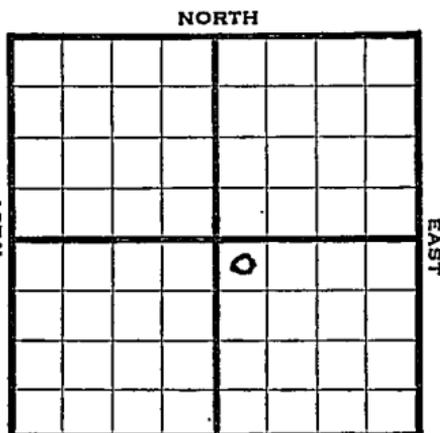

NW SE Elev. 2749

1944

REPORT

|       |                      |
|-------|----------------------|
| 8/30  | Loc.                 |
| 9/8   | "                    |
| 9/13  | "                    |
| 9/21  | "                    |
| 9/28  | "                    |
| 10/4  | "                    |
| 10/11 | "                    |
| 10/18 | "                    |
| 10/25 | "                    |
| 11/1  | "                    |
| 11/8  | "                    |
| 11/16 | Derrick              |
| 11/24 | RUR                  |
| 11/29 | "                    |
| 12/6  | "                    |
| 12/14 | Drlg. 200'           |
| 12/21 | 9" @ 386<br>1990' SD |
| 12/29 | Drlg. 2350'          |
| 1945  |                      |
| 1/3   | Drlg 2970            |
| 1/10  | Drlg 3485            |
| 1/17  | Drlg 4220'           |
| 1/26  | Drlg. 4625'          |

OVER

1945

1/31 Miss. 4628  
TD 4866'

2/7 7" @ 1916 WOC

2/14 Lost Cir  
TD 4866

2/21 " "

2/28 " "

3/7 Miss. 4620'  
Lost circulation  
TD 4866

**ABANDONED**

Pool Name Wildcat

KANSAS

Map No. NM Sec. 30 Twp. 21 R. 28W

Well No. 1 John Bly.

Singer-Prairie Company

FIRST REPORT Contractor

NW SE

SECTION FLAT

330 Ft. from N. Line

\_\_\_\_\_ Ft. from S. Line

\_\_\_\_\_ Ft. from E. Line

330 Ft. from W. Line

|  |  |   |  |
|--|--|---|--|
|  |  |   |  |
|  |  |   |  |
|  |  | o |  |
|  |  |   |  |

Finney County

Location X

Rig up \_\_\_\_\_

Drilling and Remarks:

RECORD

Cased \_\_\_\_\_ in, \_\_\_\_\_ ft.

Sand \_\_\_\_\_

Gas \_\_\_\_\_

Oil \_\_\_\_\_

Total Depth \_\_\_\_\_

PRODUCTION

1st 24 hrs. Nat. \_\_\_\_\_

1st 24 hrs. after shot \_\_\_\_\_

Gas \_\_\_\_\_ Cu. Ft.

Dry Hole \_\_\_\_\_

Abandoned \_\_\_\_\_

Date

AUG 3 0 1944 19

S. J. LEWIS Scout

Pool Name WildcatMap No. No. 1145 Sec. 30 Twp. 21 R. 28WWell No. 1 John Ely.Sinclair-Prairie CompanyABANDONED

Contractor

NW SE

## SECTION PLAT

330 Ft. from N. Line

\_\_\_\_\_ Ft. from S. Line

\_\_\_\_\_ Ft. from E. Line

330 Ft. from W. Line

|  |  |   |  |
|--|--|---|--|
|  |  |   |  |
|  |  |   |  |
|  |  | o |  |
|  |  |   |  |

Finney

Location \_\_\_\_\_

Rig up \_\_\_\_\_

Drilling and Remarks:

*Mis 4620**Loc of Circulation*

## RECORD

Cased \_\_\_\_\_ in., \_\_\_\_\_ ft.

Sand \_\_\_\_\_

Gas \_\_\_\_\_

Oil \_\_\_\_\_

Total Depth 4866

## PRODUCTION

1st 24 hrs. Nat. \_\_\_\_\_

1st 24 hrs. after shot \_\_\_\_\_

Gas \_\_\_\_\_ Cu. Ft.

Dry Hole \_\_\_\_\_

Abandoned \_\_\_\_\_

Date

MAR 7 1945 19S. J. LEWIS Scout