

KANSAS


FORM 51 5M 1-42 PETROL

Finney

Section 30 Township 21 Range 33-W

Well No. #1 First Nat'l Bank of Hays

Company Shallow Water Ref. etal

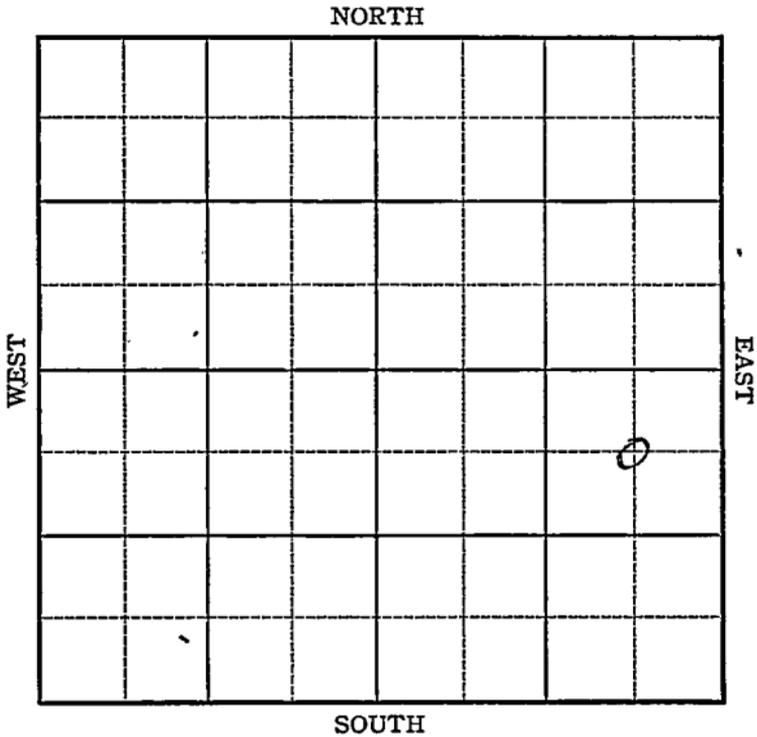

Sec. 30 Twp. 21 R. 33-W

Well No. #1 First Nat'l Bank of Hays Farm


Shallow Water Ref. et al Company

660 Ft. from N. Line

_____ Ft. from S. Line

660 Ft. from E. Line

_____ Ft. from W. Line

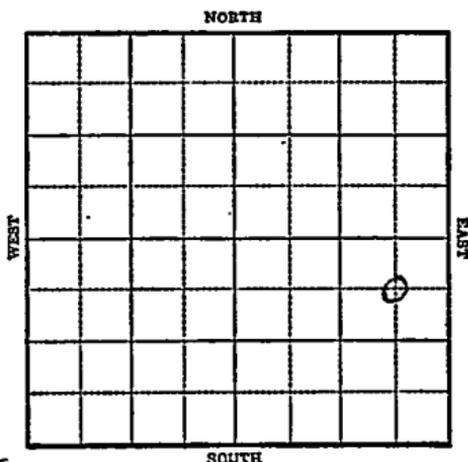

Elev. 2896

1944

R E P O R T

1-19 Location Stanolind farm-out

1/26 Derrick

2/2 10" @ 240
Drlg. 650

2/8 Drlg. 2960'

2/15 Drlg. 3370'

2/23 Lens 2897
Drlg. 4170'

3/1 Drlg. 4643

3/38 Miss 4641
TD 4750
No shows

ABANDONED

KANSAS

Map No. MM Sec. 30 Twp. 21 R. 33W

Well No. 1 First Nat'l Bank of Hays

Shallow Water Ref. etal. Company

FIRST REPORT

Contractor

C NE SE

SECTION PLAT

660 Ft. from N. Line

_____ Ft. from S. Line

660 Ft. from E. Line

_____ Ft. from W. Line

			o

Wildcat

Location X

Rig up _____

Drilling and Remarks:

Stanolind
farm-out

RECORD

Cased _____ in., _____ ft.

Sand _____

Gas _____

Oil _____

Total Depth _____

PRODUCTION

1st 24 hrs. Nat. _____

1st 24 hrs. after shot _____

Gas _____ Cu. Ft.

Dry Hole _____

Abandoned _____

Date

JAN 19 1944 19

S. J. LEWIS Scout

KANSAS
 Map No. MM Sec. 30 Twp. 21 R. 33W

Well No. 1 First Nat'l Bank of Hays

Shallow Water Ref. sta. Company
ABANDONED

Contractor

C NE SE

SECTION PLAT

660 Ft. from N. Line

_____ Ft. from S. Line

660 Ft. from E. Line

_____ Ft. from W. Line

			o

Wildcat

Location _____

Rig up _____

Drilling and Remarks:

Mis 4641

No show

RECORD

Cased _____ in., _____ ft.

Sand _____

Gas _____

Oil _____

Total Depth 4750

PRODUCTION

1st 24 hrs. Nat. _____

1st 24 hrs. after shot _____

Gas _____ Cu. Ft.

Dry Hole _____

Abandoned _____

Date

MAR 8 1944 19

S. J. LEWIS Scout