

# KANSAS

Form 51-5M-7-40-Palace


Stafford

Section 31 Township 21 Range 12-W

Well No. #1 Curtis

Company Bay Petroleum

NORTH Fisher Pool

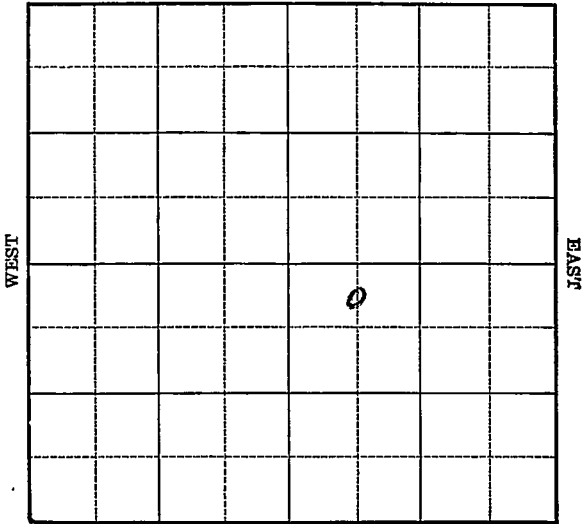

SOUTH



Map No. 46 Sec. 31 Twp. 21 R. 12W

Well No. 1 Curtis

Bay Petroleum Company

Contractor

**FIRST REPORT**

C N L NW SE

330 Ft. from N. Line


\_\_\_\_\_ Ft. from S. Line

\_\_\_\_\_ Ft. from E. Line

660 Ft. from W. Line

FISHER POOL

**SECTION PLAT**

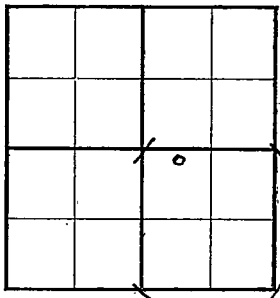

Location X

Rig up \_\_\_\_\_

Drilling and Remarks:

**RECORD**

Cased \_\_\_\_\_ in., \_\_\_\_\_ ft.

Sand \_\_\_\_\_

Gas \_\_\_\_\_

Oil \_\_\_\_\_

Total Depth \_\_\_\_\_

**PRODUCTION**

1st 24 hrs. Nat. \_\_\_\_\_

1st 24 hrs. after shot \_\_\_\_\_

Gas \_\_\_\_\_ Cu. Ft.

Dry Hole \_\_\_\_\_

Abandoned \_\_\_\_\_

Date

DEC 18 1940 19

S. J. LEWIS Scout

Map No. 46 Sec. 31 Twp. 21 R. 12WWell No. 1 CurtisBay Petroleum

Company

Contractor

ABANDONED

C N L NW SE

330 Ft. from N. Line

\_\_\_\_\_ Ft. from S. Line

\_\_\_\_\_ Ft. from E. Line

660 Ft. from W. Line

FISHER POOL

## SECTION PLAT

		o	

Location \_\_\_\_\_

Rig up \_\_\_\_\_

Drilling and Remarks:

*Lease 3300**Comp 3575**Net 3609**Comp 3660**Woshows*

## RECORD

Cased \_\_\_\_\_ in., \_\_\_\_\_ ft.

Sand \_\_\_\_\_

Gas \_\_\_\_\_

Oil \_\_\_\_\_

Total Depth 3707

## PRODUCTION

1st 24 hrs. Nat. \_\_\_\_\_

1st 24 hrs. after shot \_\_\_\_\_

Gas \_\_\_\_\_ Cu. Ft.

Dry Hole \_\_\_\_\_

Abandoned \_\_\_\_\_

Date

JAN 8 1941

S. J. LEWIS Scout