


Section 31 Township 21 Range 12W

Well No. #1, Fisher

Company Keyes Drlg. et al

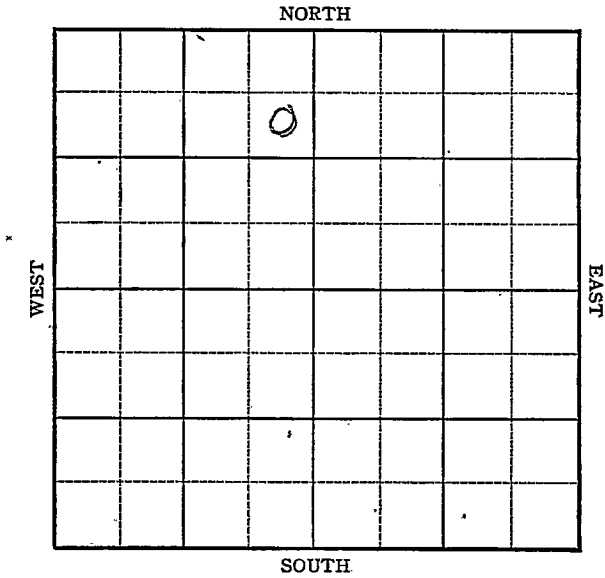

Sec. 31 Twp. 21 R. 12W

Well No. #1 Fischer Farm
Keyes Drlg. et al Company

Sittner


990 Ft. from N. Line

_____ Ft. from S. Line

330 Ft. from E. Line

_____ Ft. from W. Line

SE NE NW

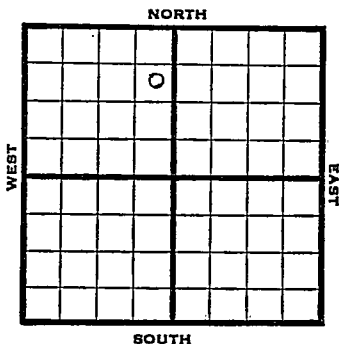

1946 Elev. 1872 REPORT

- 4/10 8" @ 263
Anhy. 692
Drlg. 1220
- 4/16 Lans 3304
Viola 3545
Simp 3585
Arb 3629-31
TD Run csg.
- 4/23 TD 3635-5" @ 3635
RUST
- 5/1 TD 3649-1500 acid
swb $\frac{1}{2}$ oil PH 4 hrs plus wtr
- 5/7 " " " "
- 5/15 Arb. 3629
5" @ 3635
TD 3651'

ABANDONED

KANSAS Kansas Pool Name Sittner

Map No. 46 Sec. 31 Twp. 21 R. 12W

Well No. 1 Fischer

Keyes Drlg. etal. Company

FIRST REPORT Contractor

SE NE NW

SECTION PLAT

990 Ft. from N. Line

| | | | |
|--|---|--|--|
| | | | |
| | o | | |
| | | | |
| | | | |
| | | | |

_____ Ft. from S. Line

330 Ft. from E. Line

_____ Ft. from W. Line

Stafford County

Location _____

RECORD

Rig up _____

Cased _____ in., _____ ft.

Drilling and Remarks:

Sand _____

Gas _____

Oil _____

Total Depth _____

8" @ 263

PRODUCTION

Anhy 692

1st 24 hrs. Nat. _____

Drlg 1220

1st 24 hrs. after shot _____

Gas _____ Cu. Ft.

Dry Hole _____

Abandoned _____

Date

APR 1 0 1946 19

S. J. LEWIS Scout

KANSAS Kansas Pool Name Sittner PoolMap No. 76 Sec. 31 Twp. 21 R. 12WWell No. 1 FischerKeyes Drlg. etal CompanyABANDONED Contractor

SE NE NW

E11872
SECTION PLAT990 Ft. from N. Line Ft. from S. Line330 Ft. from E. Line Ft. from W. Line

| | | | |
|--|---|---|--|
| | | | |
| | 0 | | |
| | | 1 | |
| | | | |

Stafford CountyLocation Rig up

Drilling and Remarks:

Per 36255-103625

RECORD

Cased in, ft.Sand Gas Oil Total Depth 3651

PRODUCTION

1st 24 hrs. Nat. 1st 24 hrs. after shot Gas Cu. Ft.Dry Hole Abandoned

Date

MAY 15 1946 19S. J. LEWIS Scout