

Stafford

FORM 51


KANSAS

Section 31 Township 21 Range 12W

Well No. 1 - Fischer

Company B & B Drlg

NORTH

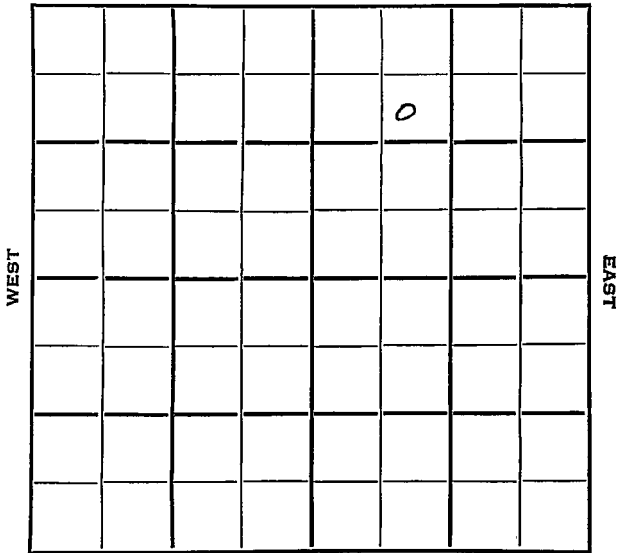

SOUTH


Sec. 31 Twp. 21 R. 12WWell No. #1 Fischer FarmB & B Drlg. CompanyB & B Drlg. Contractor990 Wildcat
Ft. from N. Line

Ft. from S. Line

Ft. from E. Line

990 Ft. from W. Line

SE NW NE

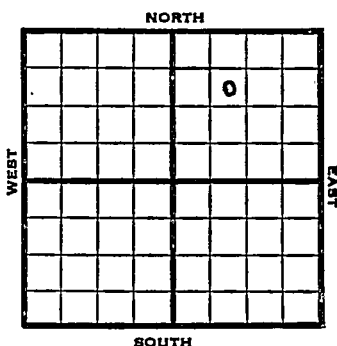

1952 Elev. 1864' REPORT

12/23 Spud 12-20-52
8" @ 250 WOC

12/25 " " "

1/1 Drlg. 2095

1/8 Heeb 3134 Br 1 3264 Lans 3280 DST 3401-18 20 mins 2½ M Gas 70' GCM 1230#
 DST 3419-118 1½ Hr. 1620' Gas 130' O & GCM 480# DST 3458-72 1 Hr. 30' SO & GCM 100' Gas Simp 3567 Arb 3621
 DST 3622-26 1¼ Hr. 30' HOCM 300' Gas 1170# DST 3624-29 40 mins 2900' Gas 1170' Oil 1150# TD 3629 5" @ 3624

1/23 Spud 12-20-52 Oil well TD 3629' 8" @ 250 Anhy 670' Heeb 3134' Br. lime 3264' Lans. 3280' DST 3401-18 open 20 min. rec 2½ MCFG 70' GCM 1230#
 DST 3419-48 open ½ hr. rec 1620' gas 130' O & GCM 480#
 DST 3458-72 open 1 hr. rec 30' SO & GCM, 100' gas O#
 Simp. 3567' Arb. 3621' DST 3622-26 open 1¼ hr, rec 30' HOCM 300' gas, 1170#
 DST 3624-29 open 40 min rec 2900' gas 1170' oil 1150#

OVER

1953

1/23

(Information continued)

TD 3629' 5" @ 3624 CO to 3629'

FU 2200' oil 4 hr.

Comp. 35 BOPD 20% wtr.

COMPLETED

County **Stafford** State **Kansas**Sec. **31** (Blk.) **21** (Sur.) **12W** Map No.Operator **B & B Drlg.**Well No. **1** Farm **Fischer**Elev. Location **SE NW NE**

FIRST REPORT

990 Ft. From **N** Line **NE**990 Ft. From **W** Line Quarter1st. Report **DEC 23 1952**

Completion

Remarks

B & B Drlg. - Contr.Spudding Date **12-20-52**Drlg. Data **Wildcat****8" @ 250 WOC**

Scout Cards

Land Small Map

Land Wall Map

Tracings

France Map

Pierce Map

Misc.

DEC 29 1952

Drig. Data

County Stafford State Kansas

Sec. 31 (Blk. Twp.) 21 (Sur. Rge.) 12W Map No.

Operator B & B Drlg.

Well No. 1 Farm Fischer

Elev.	1864	Location	SE NW NE
-------	------	----------	----------

0

COMPLETE

990 Ft. From N Line NE

990 Ft. From W Line Quarter

1st. Report

Completion **JAN 23 1953**

Remarks	Wildcat
---------	---------

B & B Drlg. - Contr.

Spudding Date 12-20-52

Drig. Data Oil well TD 3629

8" @ 250 Anhy 670 Heeb. 3134

Br. lime 3264 Lens. 3280 DST 3401-18

open 20 min. Rec. $2\frac{1}{2}$ mcf/g 70' gcm

1230# DST 3419-48 open $\frac{1}{2}$ hr. Rec.

1620' gas 130' o & g cm 480#

DST 3458-72 open 1 hr. Rec. 30' so & gcm

100' gas 0# Simp! 3567 Arb. 3621

DST 3622-26 open $1\frac{1}{2}$ hr. Rec. 30' hocrn

300' gas 1170# DST 3624-29 open 40 min

Rec. 2900' gas " 1170' oil " 1150#

TD 3629 5" @ 3624 "CO to 3629"

FU 2200' oil 4 hr. Comp. 35 bopd " 20% wtr

J. G. McGEHEE

Scout Cards	<i>mm</i>
Land Small Map	
Land Wall Map	<i>3</i>
Tracings	
France Map	
Pierce Map	
Index	

JAN 29 1953

Orig. Date