


Section 31 Township 21 Range 12 WWell No. # 2 FischerCompany Dizdar & Nye Drlg. Co.

NORTH

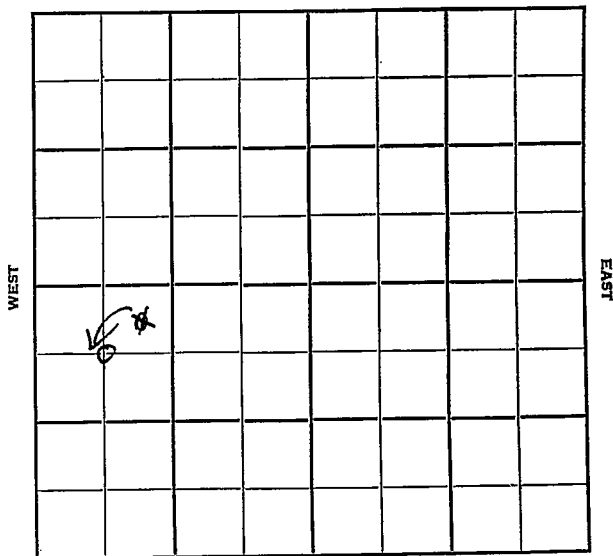

SOUTH

Stafford

KANSAS

Sec. 31 Twp. 21 R. 12W

Well No. #2 Fischer Farm

Dizdar & Nye Drlg.Co. Company

Contractor

Fischer Pool

660
330'

Ft. from N. Line


Ft. from S. Line

Ft. from E. Line

660
990'

Ft. from W. Line

~~NE NW SW~~
c NW SW

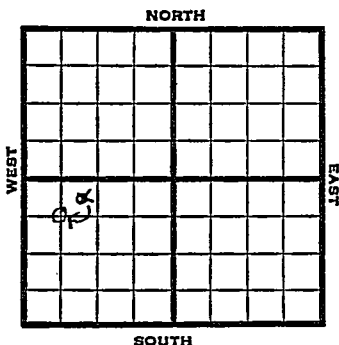

1951

Elev. 1874' REPORT


6/27

Spud 6-24-51
8" @ 260'

8/8

Spud 6-24-51
Oil well TD 3653' 8" @ 260'
Heeb 3166' Lans. 3292'
DST 3360-72 open $\frac{1}{2}$ hr. rec 12' mud
DST 3433-45 open $\frac{1}{2}$ hr. rec 6' SW
Simp. 3592' Arb. 3648'
DST 3646-53 open 20 min, rec 60' HOCM
 $4\frac{1}{2}$ " @ 3649 TD 3653' 500 A
Comp. 300 BOPD

COMPLETED

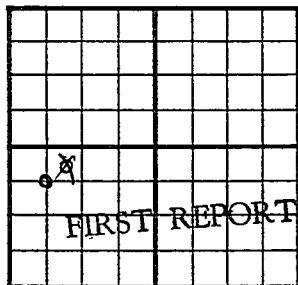County Stafford State KansasSec. 31 (Blk.) 21 (Sur.) 12W Map No.Operator Dizdar & Hye Drilling Co.Well No. 2 Farm FischerElev. Location 2 NW SW660 Ft. From N Line SW660 Ft. From N Line Quarter1st. Report JUN 27 1951

Completion

Remarks

Spudding Date 6-24-51Drig. Data Correction Fischer Pool8" @ 260

J. E. TYRA

JUL 2 1953

Scout Cards
Land Small Map
Land Wall Map 5
Tracings
France Map
Misc.

Drig. Data

Map No. _____ Sec. 31 Twp. 21 R. 12WWell No. 2 Fischer

_____ Dizdar & Nye Drlg. _____ Company

CORRECTION

Contractor

C NW SW

SECTION PLAT

660 Ft. from N. Line

_____ Ft. from S. Line

_____ Ft. from E. Line

660 Ft. from W. Line

0			

Stafford County

Location _____

Rig up _____

Drilling and Remarks:

Reported

NE NW SW

RECORD

Cased _____ in., _____ ft.

Sand _____

Gas _____

Oil _____

Total Depth _____

PRODUCTION

1st 24 hrs. Nat. _____

1st 24 hrs. after shot _____

Gas _____ Cu. Ft.

Dry Hole _____

Abandoned _____

Date

JUL 2 1951 19J. E. TYRA Scout

Scout Cards, Land Small Map, Land Wall Map, Tracings, Frame Map, Pierce Map, Misc.




RECORD

Scout Cards	mm
Land Small Map	
Land Wall Map	5
Tracings	
Frame Map	
Pierce Map	
Misc.	

JUL 6 1951

REC

County Stafford State Kansas
 Sec. 31 (Blk. 21) (Sur. 12W) Map No. 12W
 Operator Dizdar Investment & Nye Drlg.
 Well No. 2 Farm Fischer
 Elev. 1874 Location C NW SW

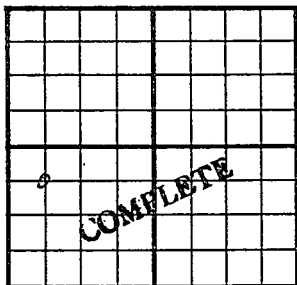

660 Ft. From N Line SW
660 Ft. From W Line Quarter

Ist. Report

Completion AUG 8 1951

Remarks Fischer Pool

Spudding Date 6-24-51

Drlg. Data Oil well TD 3653

8" @ 260 Heeb. 3166 Lans. 3292

DST 3360-72 open $\frac{1}{2}$ hr. Rec. 12' mud

DST 3433-45 open $\frac{1}{2}$ hr. Rec. 6' sw

Simp. 3592 Arb. 3648 DST 3646-53

open 20 min. Rec. 60' hocm $4\frac{1}{2}"$ @ 3649

TD 3653 500 A . Comp. 300 bopd

J. E. TYRA

Scout Cards	7777
Land Small Map	
Land Wall Map	32
Tracings	
France Map	
Pierce Map	
Misc.	

AUG 16 1951

Drig. Data