


Section 31 Township 21 Range 12WWell No. #2 Fischer "A"Company Anschutz Drlg.

NORTH

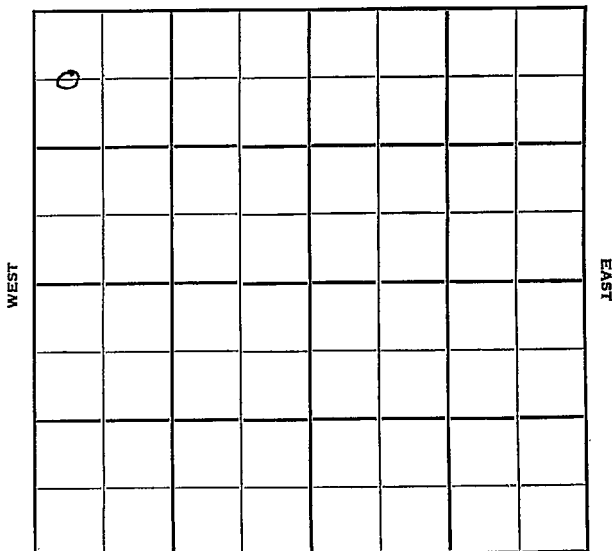

SOUTH

Stafford

KANSAS

Sec. 31 Twp. 21 R. 12 W

Well No. # 2 Fischer #A Farm

Anschutz Drlg. Company

Contractor

Marie Pool


660 Ft. from N. Line

 Ft. from S. Line

 Ft. from E. Line

330 Ft. from W. Line

G W L NW NW (Twin well)

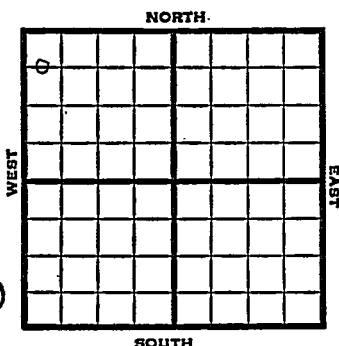

1951

Elev. 1872' REPORT

8/29

Spudding

12/5

Oil well TD 3718' 8" @ 325'

Heeb 3152' Br. lime 3280'

Lans. 3296'

DST 3414-26 open $\frac{1}{2}$ hr. rec 60' O & GCM

DST 3452-64 open 15 min. rec 1900' gas
30' OCM, 60' mud & oil.

DST 3496-3502 open 40 min. rec 10'
SOOM

Viola 3541' Re-Arb. 3619'

DST 3621-26 open 45 min. no rec.

Arb. 3630'

DST 3631-40 open 20 min. rec 240' HOOM

DST 3631-40 open 20 min. rec 480' gas
120' O & GCM, 100' VHOOM, 20' mud
& oil.

DST 3656-66 open 15 min. rec 15' mud

TD 3715' 5" @ 3714' CO to 3718'

HFW SP 3692' 114/3680-92

15 BOPD

Comp. 368 BOPD 21% water.

COMPLETED

County Stafford State Kansas
 Sec. 31 (Blk. Twp.) 21 (Sur. Rge.) 12W Map No.
 Operator Anschutz D-1g.
 Well No. 2 Farm Fischer "A"
 Elev. _____ Location C W L NW NW (~~line well~~)

0					

FIRST REPORT

660 Ft. From N Line NW
330 Ft. From W Line Quarter
 1st. Report AUG 29 1951
 Completion _____
 Remarks _____
 Spudding Date _____


Drilg. Data

Marie Pool

spdg.

J. E. TYRA

County Stafford State Kansas
 Sec. 31 (Blk.) 21 (Sur.) 12W Map No.
 Operator Anschutz Drlg.
 Well No. 2 Farm Fischer "A"
 Elev. 1872 Location C W L NW NW (twin well)

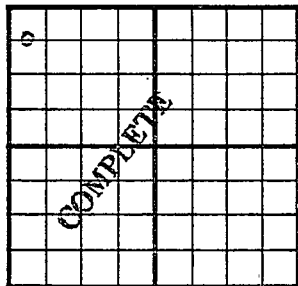

660 Ft. From N Line NW
330 Ft. From W Line Quarter

1st. Report

Completion DEC 5 1951

Remarks Marie Pool

Spudding Date

Drlg. Data Oil well TD 3718

8" @ 325 Heeb. 3152 Br. lime 3280

Lans. 3296 DST 3414-26 open $\frac{1}{2}$ hr.

Rec. 60' o & gem DST 3452-64 open 15 min.

Rec. 1900' gas 30' ocm 60' mud & oil

DST 3496-3502 open 40 min. Rec. 10' socm

Viola 3541 ReArb. 3619 DST 3621-26

open 40 min. no rec. Arb. 3630

DST 3631-40 open 20 min. Rec. 240' hocm

DST 3631-40 open 20 min. Rec. 480' gas

120' o & gem 100' vhocm 20' mud & oil

DST 3656-66 open 15 min. Rec. 15' mud

TD 3715 5" @ 3714 CO to 3718 HFW

SP 3692 114/ 3680-92 15 boph

Comp. 368 bopd 21% water

J. E. TYRA