


KANSAS Stafford County

Section 31 Township 21 Range 12W

Well No. #1 Cirtus

Company Keys Drlg.

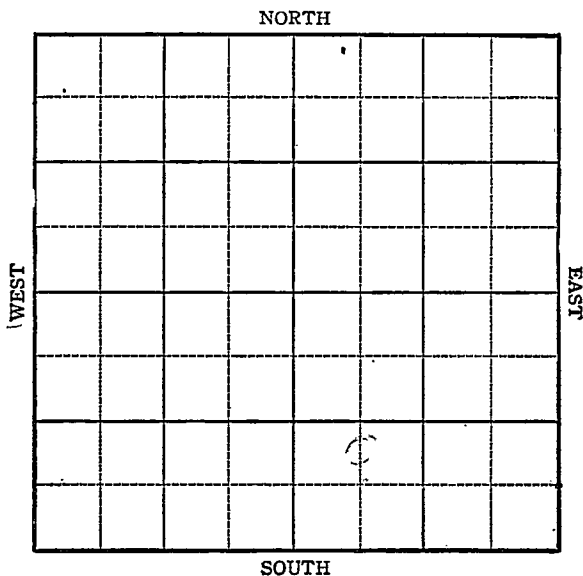

# KANSAS Stafford County

Sec. 31 Twp. 21 R. 12W

Well No. #1 Cirtus Farm

Keys Drlg. Company

Fischer


\_\_\_\_\_ Ft. from N. Line

990 Ft. from S. Line

\_\_\_\_\_ Ft. from E. Line

660 Ft. from W. Line

CNL SW SE

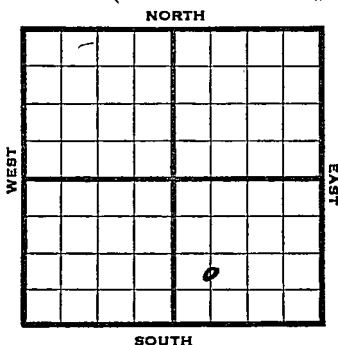

1944

## R E P O R T

10/4 10<sup>n</sup> - 253 WOC

10/11 Anhy 862  
Drlg. 2960

10/18 Lans 3302  
Arb 3638  
TD 3643  
Wtr.

**ABANDONED**



Pool Name FischerMap No. 46 **KANSAS** Sec. 31 Twp. 21 R. 12WWell No. 1 Cirtus

Keys Drilg.

Company

ABANDONED

Contractor

C N L SW SE

## SECTION PLAT

		6	

\_\_\_\_\_ Ft. from N. Line

990 Ft. from S. Line

\_\_\_\_\_ Ft. from E. Line

660 Ft. from W. Line

Stafford

Location \_\_\_\_\_

Rig up \_\_\_\_\_

Drilling and Remarks:

Lans 3302CR 8638Notes

## RECORD

Cased \_\_\_\_\_ in., \_\_\_\_\_ ft.

Sand \_\_\_\_\_

Gas \_\_\_\_\_

Oil \_\_\_\_\_

Total Depth 2643

## PRODUCTION

1st 24 hrs. Nat. \_\_\_\_\_

1st 24 hrs. after shot \_\_\_\_\_

Gas \_\_\_\_\_ Cu. Ft.

Dry Hole \_\_\_\_\_

Abandoned \_\_\_\_\_

Date

OCT 18 1944

19

S. J. LEWIS Scout