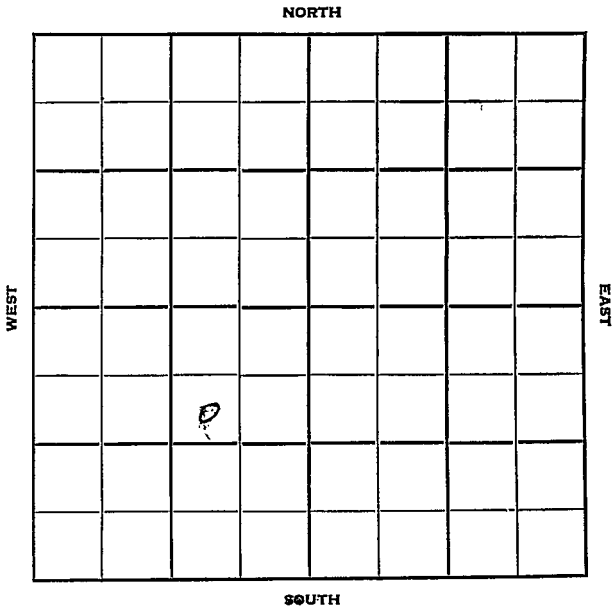


Section 31 Township 21 Range 12WWell No. #1 FischerCompany Døzdor & Nye

Stafford

KANSAS

Sec. 31 Twp. 21 R. 12 W

Well No. # 1 Fischer ☒ Farm

Dezdor & Nye Company

Contractor

Mueller Pool


990 Ft. from N. Line

Ft. from S. Line

990 Ft. from E. Line

Ft. from W. Line

SW NE SW

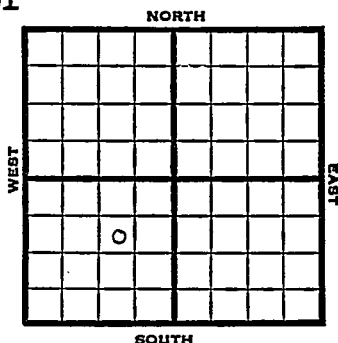

1951

Elev. 1870' REPORT

6/13

Spud 6-8-51

8" @ 244'

8/8

Spud 6-8-51

Oil well TD 3632' 8" @ 244'

Anhy 800' Lans. 3315'

DST 3365-78 open $\frac{1}{2}$ hr. rec 30' SOCM

DST 3422-35 open $\frac{1}{2}$ hr. rec 6' mud


Arb. 3629' TD 3632' 5" @ 3631'

S/1 BOPH 500 A S/25 BOPH

Comp. 300 BOPD

COMPLETED

County Stafford State Kansas
 Sec. 31 (^{Blk.}21) (^{Sur.}12W) Map No. 12W
 Operator Dizdar Investment & Nye
 Well No. 1 Farm Fischer
 Elev. 1870 Location SW NE SW

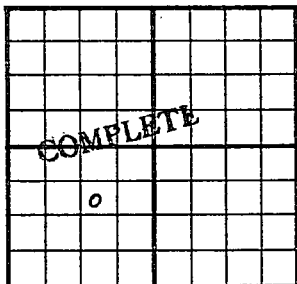

990 Ft. From N Line SW
990 Ft. From E Line Quarter
 Ist. Report _____
 Completion AUG 8 1951
 Remarks Mueller Pool
 Spudding Date 6-8-51

Drlg. Data Oil well TD 3632
8" @ 244 Anhy 800 Lans. 3315
DST 3365-78 open $\frac{1}{2}$ hr. Rec. 30' socm
DST 3422-35 open $\frac{1}{2}$ hr. Rec. 6' mud
Arb. 3629 TD 3632 5" @ 3631
S/ 1 boph 500 A S/ 25 boph
Comp. 300 bopd