

Section 31 Township 21 Range 12 W

Well No. # 3 Fischer

Company Dizdar & Nye

NORTH

		0					

WEST

EAST

SOUTH

Stafford

KANSAS

Sec. 31 Twp. 21 R. 12 W

Well No. # 3 Fischer Farm

Dizdar & Nye Company

Nye Contractor

Fischer Pool


330 Ft. from N. Line

_____ Ft. from S. Line

990 Ft. from E. Line

_____ Ft. from W. Line

NW NE SW

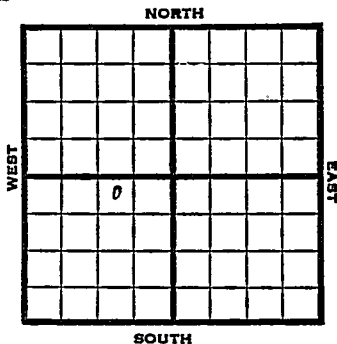

1951

Elev. 1872: REPORT

7/11

Spud 7-9-51
Drilling

8/15

Spud 7-9-51
D&A TD 3679
8" @ 262
Heeb. 3168
Br Line 3284
Lans. 3300
Viola 3557
TD 3679
D&A

ABANDONED

