KANSAS


FORM 51 5M 2-38 TPCO.

Stafford

Section 31 Township 21 Range 12-W

Well No. 1 J. K. Fischer

Company Stanolind

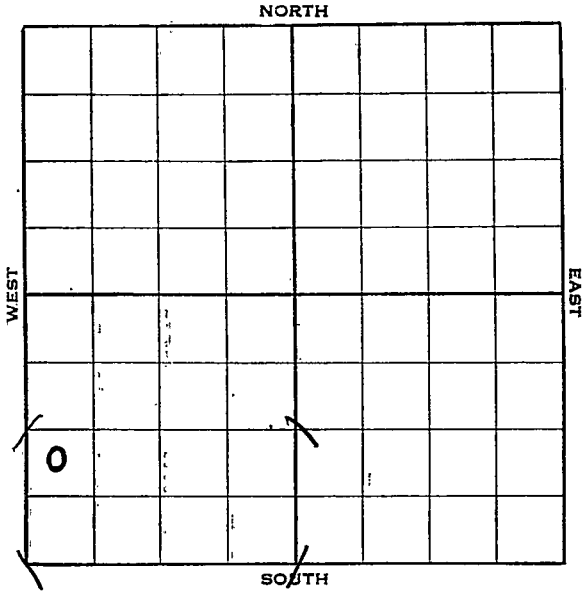

FORM 252-A 5M 1-38 KANSAS Stafford

Sec. 31 Twp. 21 R. 12-W

Well No. #1 J. K. Fischer Farm


Stanolind Company

____ Ft. from N. Line

990 Ft. from S. Line

____ Ft. from E. Line

330 Ft. from W. Line

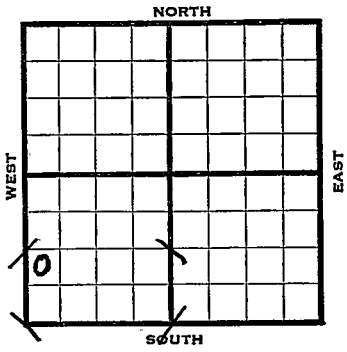

Elev. 1875

1938	REPORT
5/18	Location
5/27	S. H.
6/3	10" at 261'. Anhy 690'.
	Drlg. 2604'.
6/10	Lans. 3312'. Viola 3558'.
	Arb. 3638'. Cored 3639-43'.
	1½' recovery. Saturated.
	Running 6".
6/17	6" @ 3642'. T.D. 3649'.
	Swab 63 oil in 3 hrs.
6/22	6" @ 3642'.
	Arb. 3638'.
	T.D. 3649'.
	2000 acid.
	Pump 200 bbls. 4 hrs. &
	160 bbls. 4 hrs.
	Potential 961 bbls.
	No water.
	COMPLETED

Form 26—1M Bks.—2-29 Stafford KANSAS

Map No. 46 Sec. 31 Twp. 21 R. 12W

Well No. 1 J. K. Fischer

Stanolind Company

Contractor

FIRST REPORT

NW SW SW


Ft. from N. Line

990 Ft. from S. Line

Ft. from E. Line

330 Ft. from W. Line

SECTION PLAT

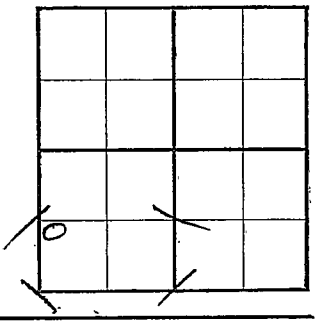

Location X

Rig up

Drilling and Remarks:

RECORD

Cased in., ft.

Sand

Gas

Oil

Total Depth

PRODUCTION

1st 24 hrs. Nat.

1st 24 hrs. after shot

Gas Cu. Ft.

Dry Hole

Abandoned

Date

MAY 18 1938

19 H. D. Hatfield Scout

Form 26—1M Bks.—2-29

Stafford KANSAS

Map No. 46 Sec. 31 Twp. 21 R. 12W

Well No. 1 J. K. Fischer

Stanolind Company

Contractor

COMPLETED

NW SW SW


Ft. from N. Line

990 Ft. from S. Line

Ft. from E. Line

330 Ft. from W. Line

SECTION PLAT

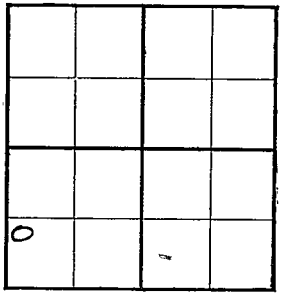

Location

Rig up

Drilling and Remarks:

2000 Acid

Pump 200/4 + 160/4

POT 961

NO WT-

RECORD

Cased 6 in., 3642 ft.

Sand A-b 3638

Gas

Oil

Total Depth 3649

PRODUCTION

1st 24 hrs. Nat.

1st 24 hrs. after shot

Gas Cu. Ft.

Dry Hole

Abandoned

Date

JUN 22 1938 19

H. D. Hatfield Scout