

KANSAS


Stafford

FORM 51 5M 1-42 PETROL

Section 31 Township 21 Range 12 W

Well No. # 3 J. K. Fischer

Company Stanolind

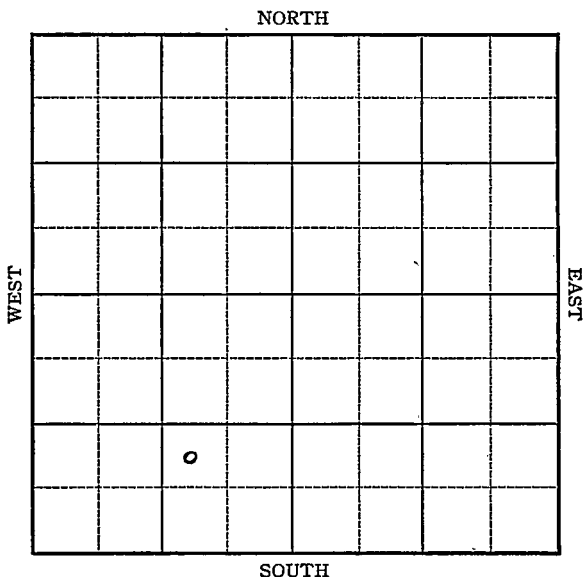

KANSAS

Stafford

Sec. 31 Twp. 21 R. 12W

Well No. #3 J. K. Fischer Farm

Stanolind Company

Fischer

NORTH

 Ft. from N. Line


990 Ft. from S. Line

990 Ft. from E. Line

 Ft. from W. Line

WEST

EAST

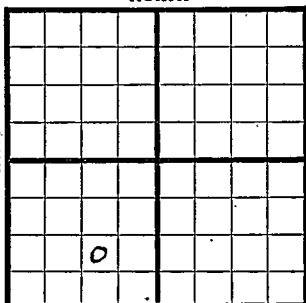

SOUTH

Eleo. 1870

1944

REPORT

5/10

Rotary

5/17

"

5/24

8" @ 230

Anhy. 682

Dr1g. 2026

5/31

Dr1g. 3404

6/7

Lans 3296

Cong. 3527

Arb. 3618-20 TD

Sat.

5" @ 3618

RUSE

6/21

Arb 3618

5" @ 3618

T.D. 3622

500 Acid

Depth Pot 1279

36.0 Gr.

COMPLETED

KANSAS

Pool Name FischerMap No. 46 Sec. 31 Twp. 21 R. 12WWell No. 3 J. K. FischerStanolind

Company

FIRST REPORT

Contractor

NW SE SW

SECTION PLAT

	o		

 Ft. from N. Line990 Ft. from S. Line990 Ft. from E. Line Ft. from W. LineStafford CountyLocation Rig up

Drilling and Remarks:

Rotary

RECORD

Cased in., ft.Sand Gas Oil Total Depth

PRODUCTION

1st 24 hrs. Nat. 1st 24 hrs. after shot Gas Cu. Ft.Dry Hole Abandoned

*

Date

MAY 10 1944

19

S. J. LEWIS

Scout

KANSAS

Pool Name FischerMap No. 46 Sec. 31 Twp. 21 R. 12WWell No. 3 J. K. FischerStanolind

Company

COMPLETED

Contractor

NW SE SW

SECTION PLAT

	o		

Ft. from N. Line

990

Ft. from S. Line

990

Ft. from E. Line

Ft. from W. Line

Stafford County

Location

Rig up

Drilling and Remarks:

Cor 83618
5" @ 3618
500 acid
Test 1279

36 2/3

RECORD

Cased _____ in., _____ ft.

Sand _____

Gas _____

Oil _____

Total Depth *3222*PRODUCTION *2,500*

1st 24 hrs. Nat. _____

1st 24 hrs. after shot _____

Gas _____ Cu. Ft.

Dry Hole _____

Abandoned _____

Date

JUN 21 1944 19

S. J. LEWIS

Scout