

Section 31 Township 21 Range 12WWell No. #3 Fischer "A"Company Anschutz Drlg.

NORTH

WEST

|   |  |  |  |  |  |  |  |
|---|--|--|--|--|--|--|--|
|   |  |  |  |  |  |  |  |
| D |  |  |  |  |  |  |  |
|   |  |  |  |  |  |  |  |
|   |  |  |  |  |  |  |  |
EAST

SOUTH

Stafford

KANSAS

Sec. 31 Twp. 21 R. 12W

Well No. #3 ~~#1~~ Fischer "A" Farm

Anschutz Drlg.

Company

Buick - Contr.

Contractor

Marie Pool


950  
990 Ft. from N. Line

Ft. from S. Line

Ft. from E. Line

280  
330 Ft. from W. Line

SW NW NW

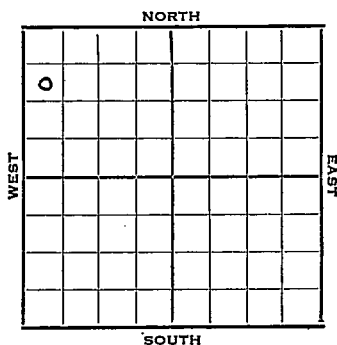

1951

Elev. 1876' REPORT

11/20

Location

1952

2/6 TD 3730 5" @ 3728

2/13

No report

2/20

Spud 11-24-51

Oil well TD 3730'

8" @ 247' Heeb 3156' Br. li 3283'

Lans. 3299'

DST 3423-32 open 1 hr. rec 30' 0 & GCM

DST 3460-90 open 1 hr. rec 1000' gas 90' HO & GCM

DST 3478-88 open 40 min. rec 40' mud

DST 3405-15 open 1 hr. rec 330' wtr.

Viola 3545' Simp. 3579'

Arb. 3635'

DST 3637-45 open 1 hr. rec 40' GCM

TD 3730' 5" @ 3728' CO to 3699

Ran Gamjaray PB 3485' 24/3464-70

16/3459-63 B/1½ GOPH 1000 A

S/90 BO 2½ hr. S/25 BO 1 hr.

Dec. to 11 BOPH P/40 BOPD 10% wtr.

8000 A P/60 BOPD

Comp. 231 BOPD 30% water.

COMPLETED

County Stafford State Kansas  
 Sec. 31 (Blk.) 21 (Sur.) 12W Map No.  
 Operator Anschutz Drlg.  
 Well No. 1 Farm Fischer "A"  
 Elev. \_\_\_\_\_ Location SW NW NW

|   |  |  |  |  |  |  |  |
|---|--|--|--|--|--|--|--|
|   |  |  |  |  |  |  |  |
| 0 |  |  |  |  |  |  |  |
|   |  |  |  |  |  |  |  |
|   |  |  |  |  |  |  |  |
990 Ft. From N Line NW  
 330 Ft. From W Line Quarter

1st. Report NOV 21 1951

Completion \_\_\_\_\_

Remarks \_\_\_\_\_

Buick - Contr.

Spudding Date \_\_\_\_\_

Drlg. Data Marie Pool

Location

Map No. \_\_\_\_\_ Sec. 31 Twp. 21 R. 12WWell No. 3 Fischer "A"

Anschutz Drlg. \_\_\_\_\_ Company

**CORRECTION**

Contractor \_\_\_\_\_

SW NW NW

## SECTION PLAT

|   |  |  |  |
|---|--|--|--|
| o |  |  |  |
|   |  |  |  |
|   |  |  |  |
|   |  |  |  |

950 Ft. from N. Line

\_\_\_\_\_ Ft. from S. Line

\_\_\_\_\_ Ft. from E. Line

380 Ft. from W. Line

Stafford County

Location \_\_\_\_\_

Rig up \_\_\_\_\_

Drilling and Remarks:

Reported

#1 Fischer "A"

## RECORD

Cased \_\_\_\_\_ in., \_\_\_\_\_ ft.

Sand \_\_\_\_\_

Gas \_\_\_\_\_

Oil \_\_\_\_\_

Total Depth \_\_\_\_\_

## PRODUCTION

1st 24 hrs. Nat. \_\_\_\_\_

1st 24 hrs. after shot \_\_\_\_\_

Gas \_\_\_\_\_ Cu. Ft.

Dry Hole \_\_\_\_\_

Abandoned \_\_\_\_\_


Date

NOV 28 1951 19

J. E. TYRA

Scout

County Stafford State Kansas  
 Sec. 31 (Blk.) 21 (Sur.) 12W Map No.  
 Operator Anschutz Drlg.  
 Well No. 3 Farm Fischer "A"  
 Elev. 1876 Location SW NW NW

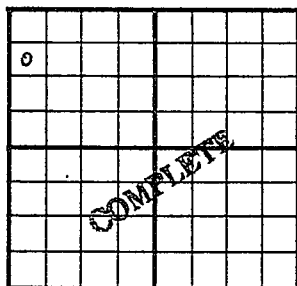

950 Ft. From N Line NW  
380 Ft. From W Line Quarter

1st. Report

Completion FEB 20 1952

Remarks Marie Pool

Spudding Date 11-24-51

Drlg. Data Oil well TD 3730

8" @ 247 Heeb. 3156 Br. lime 3283

Lans. 3299 DST 3423-32 open 1 hr.

Rec. 30' 0 & gcm DST 3460-90 open 1 hr.

Rec. 1000' gas 90' ho & gcm DST 3478-88

open 40 min. Rec. 40' mud DST 3405-15

open 1 hr. Rec. 330' water Viola 3545

Simp. 3579 Arb. 3635 DST 3637-45

open 1 hr. Rec. 40' gcm TD 3730.

5" @ 3728 CO to 3699 ran gamoray

PB 3485 24/ 3464-70 16/ 3459-63

B/ 1½ goph 1000 A S/ 90 bo 2½ hr.

S/ 25 bo 1 hr. Dec. to 11 bo ph

P/ 40 bopd 10% water 8000 A P/ 60 bopd

Comp. 231 bopd 30% water

J. G. McGEHEE