

KANSAS


FORM 51 IOM 12-46 PETROL

Stafford

Section 31 Township 21 Range 12-W

Well No. #1 M.F.A. Sittner

Company Black-Marshall

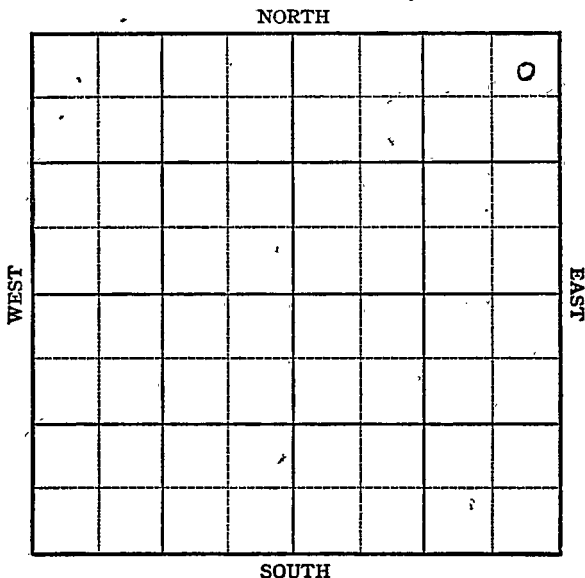

KANSAS

Sittner Pool ✓

Sec. 31 Twp. 21 R. 12-W

Well No. 1 - M. F. A. Sittner Farm

Black-Marshall Company


NE/C

330 Ft. from N. Line

_____ Ft. from S. Line

330 Ft. from E. Line

_____ Ft. from W. Line

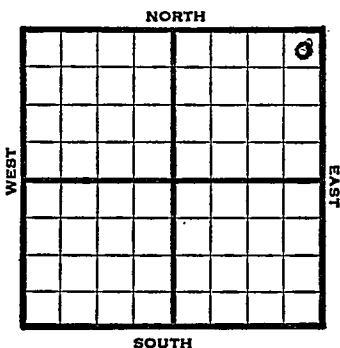

Stafford County

1947 1863

REPORT

2-12 Location

2/19 " "

2/26 " "

3/4 8" @ 285'
Drlg 1165'

3/11 Lans 3297'
Drlg 3520'

3/19 Arb 3613'
5" @ 3617'
TD 3628'

ABANDONED

Kansas

KANSAS

Sittner Pool

Map No. 46 Sec. 31 Twp. 21 R. 12WWell No. 1 M.F.A. SittnerBlack-Marshall

Company

FIRST REPORT

Contractor

NE/C

SECTION PLAT

			0

330 Ft. from N. Line

Ft. from S. Line

330 Ft. from E. Line

Ft. from W. Line

Stafford County

Location X

Rig up

Drilling and Remarks:

RECORD

Cased _____ in., _____ ft.

Sand _____

Gas _____

Oil _____

Total Depth _____

PRODUCTION

1st 24 hrs. Nat. _____

1st 24 hrs. after shot _____

Gas _____ Cu. Ft.

Dry Hole _____

Abandoned _____

Date

FEB 12 1947

19

S. J. LEWIS

Scout

Map No. 46 Sec. 31 Twp. 21 R. 12W

Well No. 1 M.F.A. Sittner

Black-Marshall Company

ABANDONED Contractor

NE/C


E1/863
SECTION PLAT

330 Ft. from N. Line

 Ft. from S. Line

330 Ft. from E. Line

 Ft. from W. Line

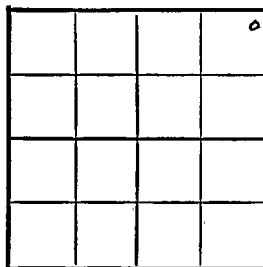

Stafford County

Location

Rig up

Drilling and Remarks:

At 83616

5" (83617)

RECORD

Cased in., ft.

Sand

Gas

Oil

Total Depth 8628

PRODUCTION

1st 24 hrs. Nat.

1st 24 hrs. after shot

Gas Cu. Ft.

Dry Hole

Abandoned

Date

MAR 19 1947 19 S. J. LEWIS Scout