


Section 31 Township 21 Range 13W

Well No. #1 Wetig

Company Petroleum Inc.

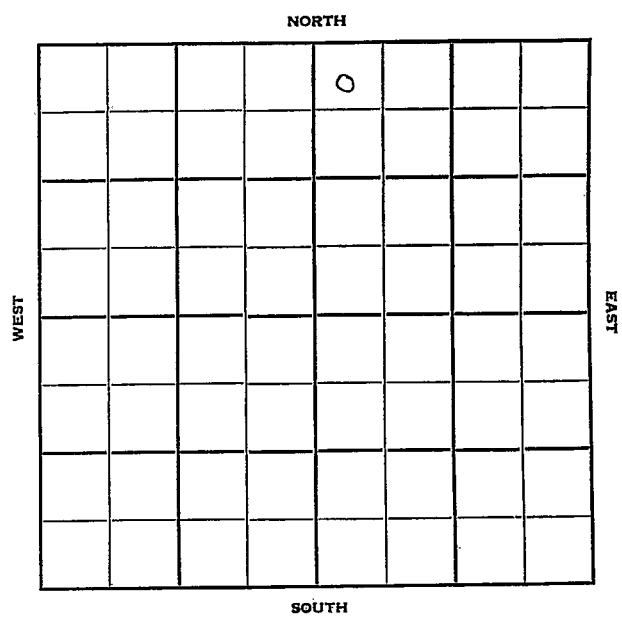

Stafford

KANSAS

Sec. 31 Twp. 21 R. 13 W ✓

Well No. # 1 Wetig Farm

Petroleum Inc.

Company

Anchultz

Contractor

Semi-Wildcat

330

Ft. from N. Line


Ft. from S. Line

Ft. from E. Line

330

Ft. from W. Line

NW NW NE

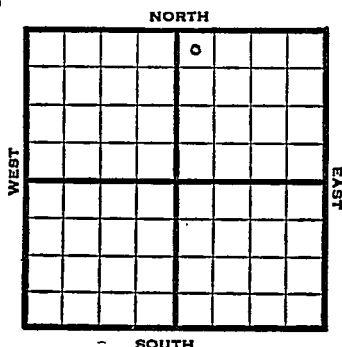

1951

Elev. 1915'

REPORT

9/19

Spud 9-17-51

8" @ 255'

Drlg. 755'

10/3

Spud 9-17-51 D & A TD 3758'

8" @ 255' Heeb. 3251' Tor. 3272'

Doug. 3287' Br. lime 3376'

Lans. 3387'

DST 3374-3420 open 45 min. rec 180' O & GCM

DST 3430-84 open 1/2 hr. rec 15' SOCM

DST 3483-3513 open 15 min. rec 5' mud

DST 3527-66 open 15 min. rec 8' mud

B KC 3603' Viola 3651'

DST 3651-80' open 15 min. rec 10' mud

Simp. 3702'

DST 3746-49 open 1/2 hr. rec 8' mud

Arb. 3750'

DST 3747-54 open 1 hr. rec 105' HOCM

120' water.

TD 3758' D & A

ABANDONED

County **Stafford** State **Kansas**Sec. **31** (Blk. Twp.) **21** (Sur. Rge.) **13W** Map No.Operator **Petroleum Inc.**Well No. **1** Farm **Wetig**Elev. Location **NW NW NE**


				0		

330 Ft. From **N** Line **NE****330** Ft. From **W** Line Quarter1st. Report **SEP 19 1951**

Completion

Remarks

Anchultz - Contr.Spudding Date **9-17-51**Drlg. Data **Semi Wildeat****8" @ 255 Drlg. 755****J. E. TYRA**

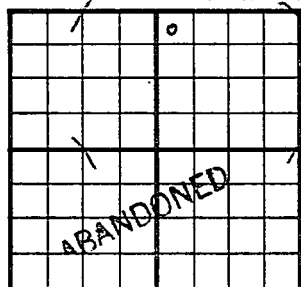County Stafford State KansasSec. 31 (Blk. Twp.) 21 (Sur. Rge.) 13W Map No. _____Operator Petroleum Inc.Well No. 1 Farm WetigElev. 1915 Location NW NW NE330 Ft. From N Line NE330 Ft. From W Line Quarter

1st. Report _____

Completion OCT 3 1951Remarks Semi WildcatAnschutz - Contr.Spudding Date 9-17-51Drlg. Data D & A TD 37588" @ 255 Heeb. 3251 Tor. 3272Doug. 3287 Br. lime 3376 Lans. 3387DST 3374-3420 open 45 min. Rec. 180' o &gcm DST 3430-84 open $\frac{1}{2}$ hr. Rec. 15' socmDST 3483-3513 open 15 min. Rec. 5' mudDST 3527-66 open 15 min. Rec. 8' mudB KC 3603 Viola 3651 DST 3651-80open 15 min. Rec. 10' mud Simp. 3702DST 3746-49 open $\frac{1}{2}$ hr. Rec. 8' mudArb. 3750 DST 3747-54 open 1 hr.Rec. 105' hoom 120' water TD 3758D & A

J. E. TYRA