


Section 31 Township 21 Range 13 W

Well No. # 3 Wetig

Company Petroleum Inc.

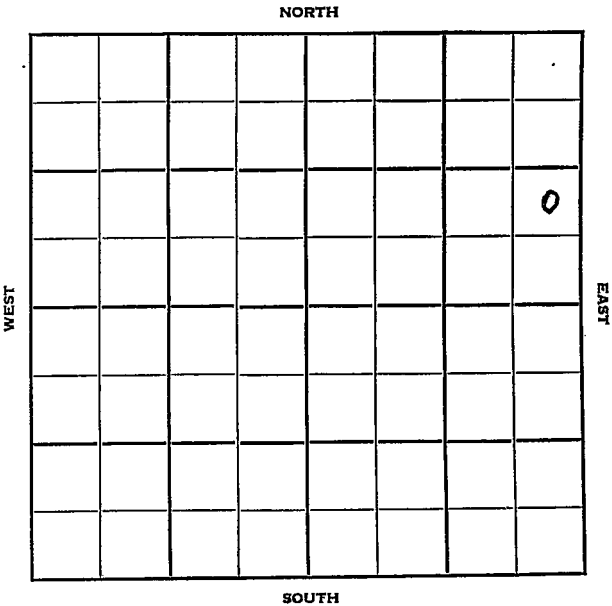

Sec. 31 Twp. 21 R. 13W

Well No. #3 Wetig Farm

Petroleum Inc. Company

Garvey Contractor

Wildcat.


 Ft. from N. Line

990 Ft. from S. Line

330 Ft. from E. Line

 Ft. from W. Line

NE SE NE

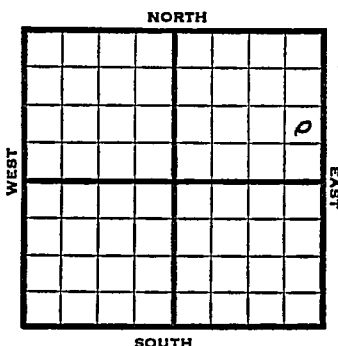

1953

Elev. 1914'

REPORT

6/17

RUR

6/24

8" @ 303'

Anhy 790, Heeb 3249, Br. L. 3374,
Lans 3386

DST 3400-3428, 3/4 hr, 6' M O#

DST 3507-20 3/4 hr, 6' M O#

7/1

Arb 3745

RTD 3804'

5" @ 3802'

7/8

NR

7/15

Spud 6-15-53

D&A

TD 3804

8" @ 303

Anhy 790, Heeb 3249, Br lime 3377, Lans
3386

DST 3400-28, opn 3/4 hrs., rec. 6' mud,
O#

DST 3507-20, opn 3/4 hrs., rec. 6' mud,
O#

DST 3520-37, opn 1 hr., rec. 20' mud,
10' ocm,

Arb. 3745

DST 3745-48, opn 3/4 hrs., rec. 5' mud

DST 3748-52, opn 3/4 hrs., rec. 5' mud

DST 3752-56, opn 1 hr., rec. 10' mud

10' ocm, 1000#

OVER

(Information Brought Forward)

1953

7/15

DST 3756-61, opn 1 hr., rec. 30' mco,
30' vhoem, 30' ocm, 30' wtr.

TD 3804

5" @ 3802

CO to 3804

16/3750-54, 250' A, 2 boph, 500A

S/3 bfph 26% wtr., 8 hrs.

2000A HFW

D&A

ABANDONED


J. G. McGEHEE

NOV 18 1953

Scout Cards	_____
Land Small Map	_____
Land Wall Map	_____
Tracings	_____
France Map	_____
Piercé Map	_____
Misc.	_____

Orig. Data

County Stafford State Kansas
 Sec. 31 (Blk.) 21 (Sur.) 13W Map No.
 Operator Petroleum Inc.
 Well No. 3 Farm Wetig
 Elev. 1914 Location NE SE NE

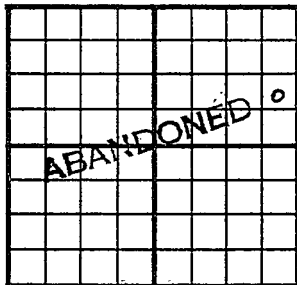

990 Ft. From S Line NE
330 Ft. From E Line Quarter
 Ist. Report
 Completion JUL 15 1953
 Remarks Wildcat
Garvey - Contr.
 Spudding Date 6-15-53

Drlg. Data D & A TD 3804
8" @ 303 Anhy 790 Heeb. 3249
Br. lime 3377 Lans. 3386 DST 3400-28
open 3/4 hr. Rec. 6' mud 0# DST 3507-20
open 3/4 hr. Rec. 6' mud 0# DST 3520-
37 open 1 hr. Rec. 20' mud 10' ocm
Arb. 3745 DST 3745-48 open 3/4 hr.
Rec. 5' mud DST 3748-52 open 3/4 hr.
Rec. 5' mud DST 3752-56 open 1 hr.
Rec. 10' mud 10' ocm 1000# DST 3756-
61 open 1 hr. Rec. 30' mco 30' whocm
30' ocm 30' wtr. TD 3804 5" @ 3802
CO to 3804 16/ 3750-54 250 A 2 boph
500 A S/ 3' bfph 26% wtr. 8 hr.
2000 A HFW

D & A

J. G. McGEHEE

JUL 29 1953

Scout Cards	100
Land Small Map	
Land Wall Map	5
Tracings	
France Map	
Pierce Map	
Misc.	

Drig. Data