


Section 31 Township 21 Range 15W

Well No. #1 Houser

Company Honaker Drig.

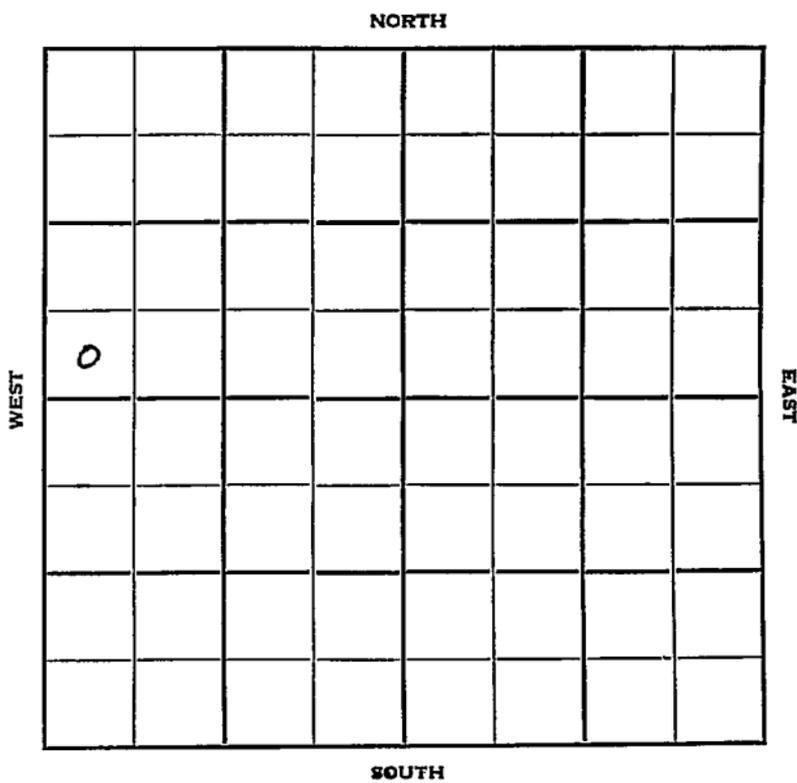

Sec. 31 Twp. 21 R. 15W

Well No. #1 Houser Farm

Honaker Drlg. Company

Semi-Wildcat Contractor


Ft. from N. Line

330' Ft. from S. Line

Ft. from E. Line

330' Ft. from W. Line

SW SW NW

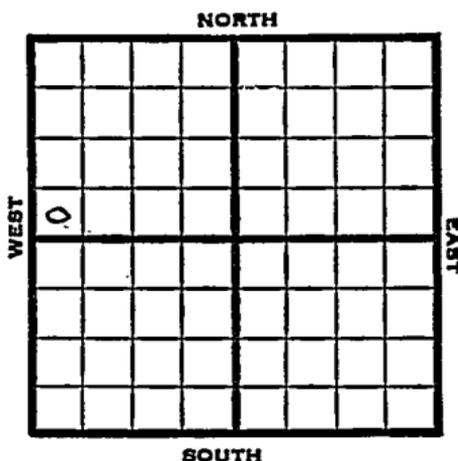

1951 Elev. 1975' REPORT

2/28 Spud 2-23-51
8" @ 950
Drlg. 1300'

3/28 Spud 2-23-51
D&A TD 3955
8" @ 950'
Anhy 940' Heeb. 3362
Lans. 3482'
DST 3477-98 opn 1/2 hr
Rec. 30' mud SSO
DST 3867-82 opn 45 mins
Rec. 12' mud DST 3505-23 opn 30 min
Rec. 75' o & gcm
Viola 3791' Simp 3844'
Arb. 3899'
Cored 3905-55 Rec. 50' Dol. & SO
(Oil 3919-25 3942-46 3946-55)
TD 3955 5" @ 3954
CO to 3947 3/3936-37 S/28 gwph
6/3938-42 B/1 gwph SP 3934
6/3922-24 S/1 1/2 bwph 12/3917-18
S/3 bwph SP 3890
6/3874-76 12/3870-76 water
12/3866-72 12/3603-07 12/3508-10
12/3485-90 S/water D&A

ABANDONED

County Pawnee State Kansas

Sec. 31 (Blk.) 21 (Sur.) 15W Map No.

Operator Honaker Drlg.

Well No. 1 Farm Houser

Elev. _____ Location SW SW NW

| | | | | | | | |
|--|--|--|--|--|--|--|--|
| | | | | | | | |
| | | | | | | | |
330 Ft. From S Line NW

330 Ft. From W Line Quarter

1st. Report FEB 28 1951

Completion _____

Remarks Stano. farmout & DFM

Spudding Date 2-23-51

Drlg. Data Semi Wildcat

8" @ 950 drlg. 1300

J. E. TYRA

