


Section 31 Township 21 Range 15-W

Well No. #1 M. Robert

Company Cities Service Oil

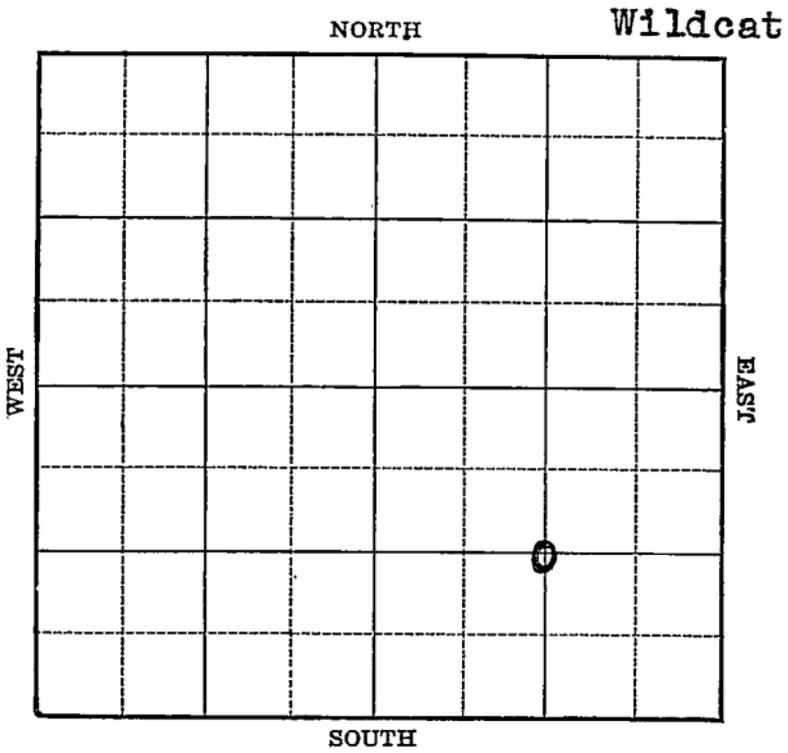

Sec. 31 Twp. 21 R. 15-WWell No. #1 M. Robert FarmCities-Service Oil Company


(Wildcat)

\_\_\_\_\_ Ft. from N. Line

1320 Ft. from S. Line1320 Ft. from E. Line

\_\_\_\_\_ Ft. from W. Line

Elev. 1986

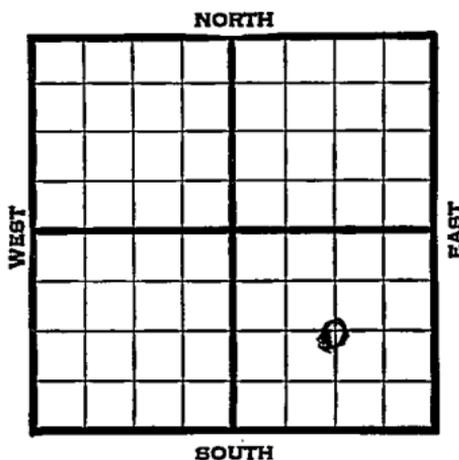

1939	REPORT
8/9	12 $\frac{1}{2}$ " - 139' Drlg. 800'
8/17	Anhy 950' 8" - 964' Drlg. 2601'
8/24	Ft. Riley 2070' Neva 2665' Topeka 3070' Lans. 3500' Drlg. 3718' No shows.
8/31	Cong. 3830' Simp. 3875' Arb. 3924' Cored 3926-36' T.D. Some saturation. 5" - 3926' RUST.
9/6	Arb. 3923' 5" - 3926' T.D. 3945' 2875 water in 18 $\frac{1}{2}$ hours. No oil.
	ABANDONED

Map No. 82 Sec. 31 Twp. 21 R. 15WWell No. I. M. RobertCities Service Oil

Company

Contractor

## FIRST REPORT

C SE

         Ft. from N. Line1320 Ft. from S. Line1320 Ft. from E. Line         Ft. from W. Line

WILDCAT

## SECTION PLAT

			⊙

Location                                 Rig up                                 

Drilling and Remarks:

12 $\frac{1}{2}$ " - 139Drlg. 800

## RECORD

Cased          in.,          ft.Sand                                 Gas                                 Oil                                 Total Depth                         

## PRODUCTION

1st 24 hrs. Nat.                         1st 24 hrs. after shot                         Gas                                  Cu. Ft.Dry Hole                                 Abandoned                                 

Date

AUG 7 1939

19

S. J. LEWIS

Scout

Pawnee **KANSAS**Map No. 82 Sec. 31 Twp. 21 R. 15WWell No. 1 M. RobertCities Service Oil Company

Contractor

**ABANDONED****C/SE****SECTION PLAT**


\_\_\_\_\_ Ft. from N. Line

1320 Ft. from S. Line1320 Ft. from E. Line

\_\_\_\_\_ Ft. from W. Line

**WILDCAT****RECORD**

Location \_\_\_\_\_

Cased \_\_\_\_\_ in., \_\_\_\_\_ ft.

Rig up \_\_\_\_\_

Sand \_\_\_\_\_

Drilling and Remarks:

Gas \_\_\_\_\_

Oil \_\_\_\_\_

Total Depth 3945*Cr 83923**5" @ 8926**2875 Water 18 1/2 lbs**Modil***PRODUCTION**

1st 24 hrs. Nat. \_\_\_\_\_

1st 24 hrs. after shot \_\_\_\_\_

Gas \_\_\_\_\_ Cu. Ft.

Dry Hole \_\_\_\_\_

Abandoned \_\_\_\_\_

Date

SEP 6 1939  
19

S. J. LEWIS Scout