
FORM 51

Pawnee KANSAS

Section 31 Township 21 Range 15W

Well No. 1Roberts

Company Welch & OlssonDrlg. & Derby Oil

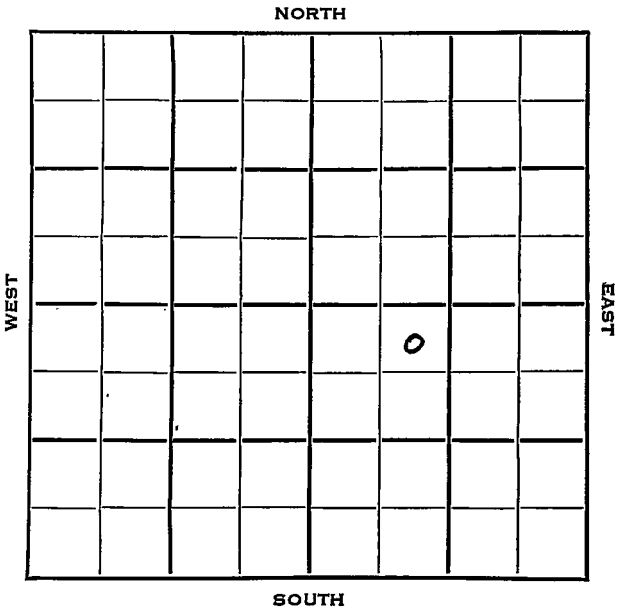

Pawnee KANSAS

SEC.	TWP.	R.
31	21	15W

WELL NO. #1 Roberts FARM

COMPANY Welch & Olsson Drlg. & Derby Oil

CONTRACTOR Welch & Olsson


~~NE Evers Pool~~

330 Ft. from N. Line

Ft. from S. Line

Ft. from E. Line

990 Ft. from W. Line

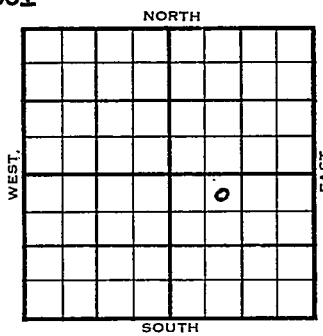

NE NW SE

1954	ELEVATION 1983' REPORT
2/10	Spud 2-6-54 8 @ 568' Dflg 2310'
2/17	Anhy 953', Heeb 3367', Tor 3385', Br li 3483', Lans 3494' DST 3524-37', 1 hr., 30' socm, 100# B KC 3728, Marm 3752', Cong 3757', V 3818, Simp 3864', Arb. 3909' DST 3910-15, 1 hr., 120' clean oil, 140' mco, 10' sw, 1250# RTD 3915' 5" @ 3911'
2/24	WOCT
3/3	CO 3915', FU 300' gassy oil, 1000# A F 3.7 boph 9 hrs. dec., testing
3/10	F 28 BO 14 hrs., 1/4" Ch
3/17	NR
3/24	"

OVER

DX-78

1954
4/14 Spud 2-6-54
Oil Well
TD 3918'
8" @ 568'
Anhy 953', Heeb 3367', Tor 3385', Br. Lime 3483', Lans 3494'
DST 3524-37', opn 1 hr., rec. 30' socm, 300#
B KC 3728', Marm. 3752', Cong 3757', Viola 3818', Simp. 3864', Arb. 3909'
DST 3910-15', opn 1 hr., rec. 120' clean oil, 140' mco, 10' sw, 1250#
TD 3915'
5" @ 3911'
CO to 3915
FU 300' gassy oil, 1000A
F/3.7 boph 9 hrs.
F/130 bf 39 hrs.., dec. to 2 bfph 60% wtr.
DD 3918', 3000 A
S&F 16 boph, dec. to 12 boph
F 2 boph
F 28 bo 14 hrs.
Comp. F & P 11 bfpd 50% oil

COMPLETED

FORM 275 FOR SALE BY KANSAS BLUE PRINT CO.


County Pawnee State Kansas

Sec. 31 (Blk. Twp.) 21 (Sur. Rge.) 15W Map No.

Operator Welch & Olsson Drlg. & Derby Oil

Well No. 1 Farm Roberts

Elev. Location NE NW SE

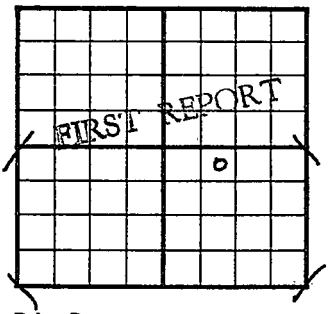

330 Ft. From N Line SE

990 Ft. From W Line Quarter

1st. Report FEB 10 1954

Completion

Remarks

Welch & Olsson - Contr.


Spudding Date 2-6-54

NE Evers Pool

Drlg. Data

8" @ 568 drlg. 2310

J. G. McGEHEE

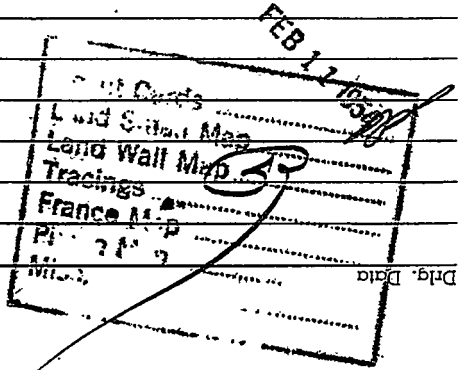
FEB 1 1 1952
Land Wall Map
Tracings
France Map
Misc.
Drlg. Data

FORM 275 FOR SALE BY KANSAS BLUE PRINT CO.


County Pawnee State Kansas

Sec. 31 (Blk. Twp.) 21 (Sur. Rge.) 15W Map No.

Operator Welch & Olsson Drlg. & Derby Oil

Well No. 1 Farm Roberts

Elev. 1983 Location NE NW SE

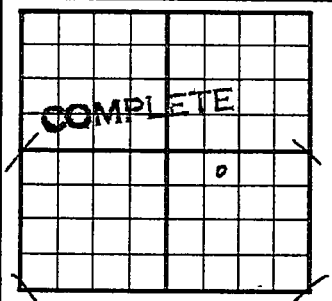

330 Ft. From N Line SE

990 Ft. From W Line Quarter

1st. Report

Completion APR 14 1954

Remarks NE Evers Pool

Welch & Olsson - Contr.

Spudding Date 2-6-54

Drlg. Data Oil well TD 3918

8" @ 568 Anhy 953 Heeb. 3367

Tor. 3385 Br. lime 3483 Lans. 3494

DST 3524-37 open 1 hr. Rec. 30' socm

100# B KC 3728 Marm. 3752 Cong. 3757

Viola 3818 Simp. 3864 Arb. 3909

DST 3910-15 open 1 hr. Rec. 120' clean

oil 140' mco 10' sw 1250# TD 3915

5" @ 3911 CO to 3915 FU 300' gassy oil

1000 A F/ 3.7 boph 9 hr. F/ 130 bf

39 hr. dec. to 2 bfph 60% wtr.

DD 3918 3000 A S & F/ 16 boph dec. to

12 boph F/ 2 boph F/ 28 bo 14 hr.

Comp. F & P/ 11 bfpd 50% oil

J. G. McGEHEE

APR 20 1954

Scout Cards
Land Small Map
Land Wall Map
Tracings
France Map
Pierce Map
Misc.

Drlg. Data