


Section 31 Township 21 Range 11 WWell No. # 1 Mellies "B"Company Black Cat et al

NORTH

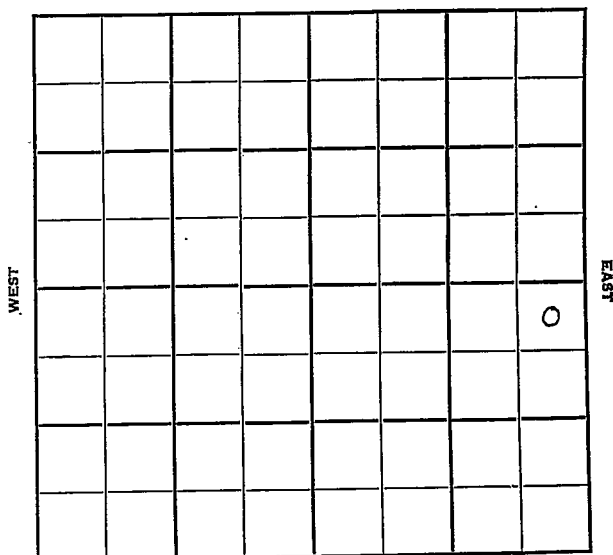

SOUTH

Stafford

KANSAS

Sec. 31 Twp. 21 R. 11 W ✓

Well No. # 1 Mellies "B" Farm

Black Cat et al Company

Contractor

~~Wildcat~~ Semi-Wildcat


330 Ft. from N. Line

Ft. from S. Line

330 Ft. from E. Line

Ft. from W. Line

NE NE SE

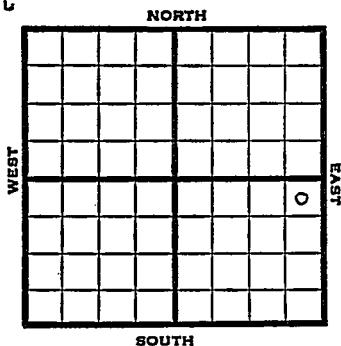

1951

Elev. 1753' REPORT

4/18

R U R

5/9

Spud 4-20-51

D&A TD 3606

8" @ 160

Anhy 475 Heeb. 3002

Br Lime 3130 Lans. 3154


Cong. 3426 Arb. 3596

TD 3606'

D&A


ABANDONED

County Stafford State Kansas
 Sec. 31 (^{Blk.}21) (^{Sur.}11W) Map No. 11W
 Operator Black Cat et al.
 Well No. 1 Farm Mellies "B"
 Elev. _____ Location NE NE SE

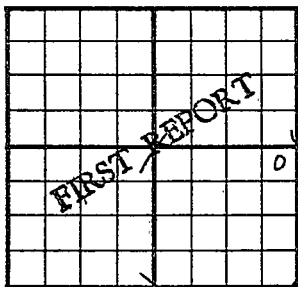

330 Ft. From N Line SE
330 Ft. From E Line Quarter
 Ist. Report APR 18 1951
 Completion _____
 Remarks _____
 Spudding Date _____

Drlg. Data Semi Wildcat
R U R

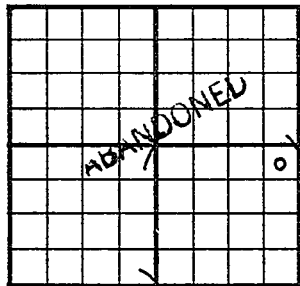County Stafford State KansasSec. 31 (Blk.) 21 (Sur.) 11W Map No.Operator Black Cat et al.Well No. 1 Farm Mellies "B"Elev. 1753 Location NE NE SE330 Ft. From N Line SE330 Ft. From E Line Quarter

1st. Report

Completion MAY 9 1951Remarks Semi WildcatSpudding Date 4-20-51Drig. Data D & A TD 36068" @ 160 Anhy 475 Heeb. 3002Br. lime 3130 Lans. 3154 Cong. 3426Arb. 3596 TD 3606D & A

J. E. TYRA