

31

21

11W

Section _____ Township _____ Range _____

Well No. #1 Mellies

Company Dizdar Inv. et al

NORTH

				0			

WEST

EAST

SOUTH

Sec. 31 Twp. 21 R. 11-W

Well No. #1 Mellies Farm

Dizard Inv. et al Company

Duke & Wood Contractor

Wildcat


330 Ft. from N. Line

_____ Ft. from S. Line

_____ Ft. from E. Line

330 Ft. from W. Line

NW NW NE

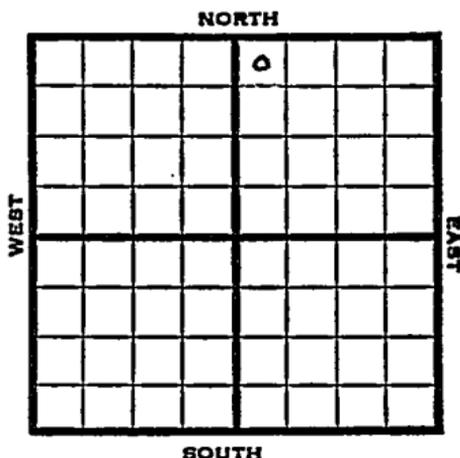

1951 Elev 1767' REPORT

1/3 Spud 12-26-50
Drlg 2765'

2/14 Spud 12-26-50
Oil Well TD 3532
8" @ 220' Anhy 515'
Heeb. 3031' Br Lime 3162'
Lans. 3187'
DST 3473-80 opn 20 min. Rec.
2400' oil Cong. 3452'
TD 3532 5" @ 3511' 41/3482-89
S/7 boph 29/3475-80 S/42 boph
S/59 boph Comp. 360 bopd 15% wtr.

COMPLETED

3187
1767

1420

3452
1767

1685

County Stafford State Kansas

Sec. 31 (Blk. 21 (Sur. Rge.) 11W Map No.

Operator Dizdar Inv. etal.

Well No. 1 Farm Mellies

Elev. 1767 Location NW NW NE

		10		

330 Ft. From N Line NE

330 Ft. From W Line Quarter

1st. Report JAN 3 1951

Completion _____

Remarks _____

Duke & Wood - Contr.

Spudding Date 12-26-50

Drlg. Data Wildcat

drlg. 2765

County Stafford State Kansas

Sec. 31 (Blk. 21) (Sur. 11W) (Twp. 11W) Map No.

Operator Dizard Inv. etal.

Well No. 1 Farm Mellies

Elev. 1767 Location NW NW NE

330 Ft. From N Line NE

330 Ft. From W Line Quarter

1st. Report

Completion FEB 14 1951

Remarks Wildcat

Duke & Wood - Contr.

Spudding Date 12-26-50

Drlg. Data Oil well TD 3532

8" @ 220 Anhy 515 Heeb. 3031

Br. lime 3162 Lans. 3187 DST 3473-80

open 20 min. Rec. 2400' oil Cong. 3452

TD 3532 5" @ 3511 41/ 3482-89

S/ 7 boph 29/ 3475-80 S/-42 boph

S/ 59 boph Comp. 360 bopd 15% water

J. E. TYRA